

**SURVEY &  
REMONUMENTATION**

APR 25 1995

**COMMISSION**

**LAND CORNER RECORDATION CERTIFICATE  
Filing Requirement of Act 74, Mich. P.A. 1970**

RECEIVED

1994 NOV 23 PM 3:54

*Linda Lushbiller*  
WEXFORD COUNTY, MI  
REGISTERED CLERK

For corners in

Wexford

(County)

Located In:

Corner Code #

- |                                    |                           |             |
|------------------------------------|---------------------------|-------------|
| 1. Public Land Survey              | T <u>24N</u> R <u>10W</u> | <u>E-13</u> |
|                                    | T _____ R _____           | _____       |
|                                    | T _____ R _____           | _____       |
|                                    | T _____ R _____           | _____       |
| 2. Property Controlling in Section | S _____ T _____ R _____   | _____       |
|                                    | S _____ T _____ R _____   | _____       |
| 3. Miscellaneous Property in Sec.  | S _____ T _____ R _____   | _____       |
|                                    | S _____ T _____ R _____   | _____       |

Register of Deeds Stamp & File Number

4. Lot No. \_\_\_\_\_, Recorded Plat \_\_\_\_\_
5. Private Claims \_\_\_\_\_

	A	B	C	D	E	F	G	H	I	J	K	L	M
2	6	5	4	3	2	1							
3													
4	7	8	9	10	11	12							
5													
6	18	17	16	15	14	13							
7													
8	19	20	21	22	23	24							
9													
10	30	29	28	27	26	25							
11													
12	31	32	33	34	35	36							
13													

I, George D. Smith, in a field survey on July 5, 1994, do hereby certify that under requirements of P.A. 74, Michigan P.A. of 1970, the corner points mentioned in lines 1 and 2 above were in conformance with regulations and rules therefore as required in the current manual of survey instructions of the United States Department of the Interior, Bureau of Land Management or by a decree of a Court of Law and/or that the corner points mentioned in lines 3, 4 and 5 above were in conformance with the rules of the Michigan Board of Land Surveyors or by a Decree of a Court of Law, established, re-established, monumented, re-monumented, recovered, found as expressed below:

**NOTE: Not more than 4 corners, all in the same town and range, may be recorded on this certificate.**

A. Description of original monument and accessories and/or subsequent restoration:

- E-13) 1838 GLO Section post by John Brink, Deputy Surveyor, Sugar 5 N 41° E 21, Sugar 12 N 33° W 30
- E-13) 1852 GLO subdivision of Sections 5 & 4, T23N, R10W by L.S. Scranton, Deputy Surveyor, Beech 10 S 20° E 9, Elm 10 N 71 W 22
- E-13) 1901 D.E. Teed survey, Liber 1, page 347, Corner found (no description given), Birch 12 S 7° W 56', Sugar 12 S 15° E 53'
- E-13) 1963 Ostling LCRC, Liber 3, page 73, Found large piece of Iron at corner at intersection of road East-West, North-South, set 1/2" Iron, 12" H. Maple S 10° E 116.3', 18" H. Maple S 71° W 89.3'
- E-13) 1980 J.L. Wilcox LCRC, Found 1" pipe with fitting, set Wexford Co. monument S 45° W, corner fence post 45.42', N 45° W corner fence post 40.32', S 10° E 12" H. Maple 116.3', S 71° W 18" H. Maple 89.3'

B. Description of corner evidence found and/or method applied in restoring or reestablishing corner:

Found Wexford County monument (poor condition) and remains of 1" pipe with fittings ± centerline road East-West and South, and 2' East of centerline North. This corner is accepted as a careful and faithful perpetuation of the position of the original corner, being the Section corner common to Sections 32 and 33, T24N, R10W and Sections 4 and 5, T23N, R10W.


C. Description of monument for corner and accessories established to perpetuate locating the position of the corner:

Set 5/8" x 36" iron with Wexford County brass cap, stamped SE 32, 1994, PS 33989

- N 43° W - 40.45' - Corner fence post
- S 75° W - 90.40' - 28" Maple
- S 5° E - 116.75' - 24" Maple
- N 50° E - 36.12' - Fence post
- S 48° E - 115.69' - 7" Cherry

Peer Group Reviewed and Approved

Date: 11-21-94  
*Richard D. Wilcox*  
Richard D. Wilcox, Wexford County Surveyor

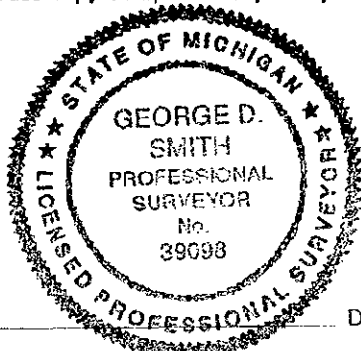

Signed by *George D. Smith*  
Surveyor's Michigan License No. 39098

Date 11/17/94