

**SURVEY &
REMONUMENTATION**

APR 25 1995

COMMISSION

**LAND CORNER RECORDATION CERTIFICATE
Filing Requirement of Act 74, Mich. P.A. 1970**

RECEIVED

1994 NOV 23 PM 3: 54

Linda Loughmiller
WEXFORD COUNTY, MI
REGISTER OF DEEDS

For corners in

Wexford
(County)

Located In:

Corner Code #

- | | | |
|------------------------------------|---------------------------|-------------|
| 1. Public Land Survey | T <u>24N</u> R <u>10W</u> | <u>F-13</u> |
| | T _____ R _____ | _____ |
| | T _____ R _____ | _____ |
| | T _____ R _____ | _____ |
| 2. Property Controlling in Section | S _____ T _____ R _____ | _____ |
| | S _____ T _____ R _____ | _____ |
| 3. Miscellaneous Property in Sec. | S _____ T _____ R _____ | _____ |
| | S _____ T _____ R _____ | _____ |

Register of Deeds Stamp & File Number

4. Lot No. _____, Recorded Plat _____
5. Private Claims _____

| | A | B | C | D | E | F | G | H | I | J | K | L | M |
|----|----|----|----|----|----|----|---|---|---|---|---|---|---|
| 2 | 6 | 5 | 4 | 3 | 2 | 1 | | | | | | | |
| 3 | | | | | | | | | | | | | |
| 4 | 7 | 8 | 9 | 10 | 11 | 12 | | | | | | | |
| 5 | | | | | | | | | | | | | |
| 6 | 18 | 17 | 16 | 15 | 14 | 13 | | | | | | | |
| 7 | | | | | | | | | | | | | |
| 8 | 19 | 20 | 21 | 22 | 23 | 24 | | | | | | | |
| 9 | | | | | | | | | | | | | |
| 10 | 30 | 29 | 28 | 27 | 26 | 25 | | | | | | | |
| 11 | | | | | | | | | | | | | |
| 12 | 31 | 32 | 33 | 34 | 35 | 36 | | | | | | | |
| 13 | | | | | | | | | | | | | |

I, George D. Smith, in a field survey on July 7, 19 94, do hereby certify that under requirements of P.A. 74, Michigan P.A. of 1970, the corner points mentioned in lines 1 and 2 above were in conformance with regulations and rules therefore as required in the current manual of survey instructions of the United States Department of the Interior, Bureau of Land Management or by a decree of a Court of Law and/or that the corner points mentioned in lines 3, 4 and 5 above were in conformance with the rules of the Michigan Board of Land Surveyors or by a Decree of a Court of Law, established, re-established, monumented, re-monumented, recovered, found as expressed below:

NOTE: Not more than 4 corners, all in the same town and range, may be recorded on this certificate.

A. Description of original monument and accessories and/or subsequent restoration:

- F-13) 1838 GLO Quarter Section post by John Brink, Deputy Surveyor, Hemlock 10 N 76 1/2° E 05, Cedar 12 N 37 1/2° W 31
- F-13) 1901 D.E. Teed, Liber 1, page 347, Corner found (no description given), Hemlock 18 S 35 1/2° W 56, Hemlock 16 S 25° E 59.5
- F-13) 1963 Ostling land corner recorded for the Michigan Department of Conservation, Set 1" x 24" pipe, 8" Cedar S 44° W 55.80', 8" Cedar N 35° W 54.90'
- F-13) 1964 Ostling survey for the Dept. of Conservation, Ref. Plan No. R-83L, Set 1" pipe in line with an old fence line North and South, and on line between Section corners, 8" Cedar S 44° W 55.80', 8" Cedar N 35° W 54.90'


B. Description of corner evidence found and/or method applied in restoring or reestablishing corner:

Found 1" pipe (top bent) ±2' North centerline East-West road opposite old barb wire fence North-South. This corner is accepted as a careful and faithful reestablishment of the position of the original corner, being the 1/4 corner common to Section 33, T24N, R10W and Section 4, T23N, R10W.

C. Description of monument for corner and accessories established to perpetuate locating the position of the corner:

Set 5/8" x 36" iron with Wexford County brass cap stamped S 1/4 33, 1994, PS 33989

- N 42° W - 56.07' - 18" Cedar (old blaze)
- S 5° W - 78.93' - 12" Cedar
- N 1° W - 42.69' - 6" Cedar
- N 25° E - 58.12' - 5" Cedar

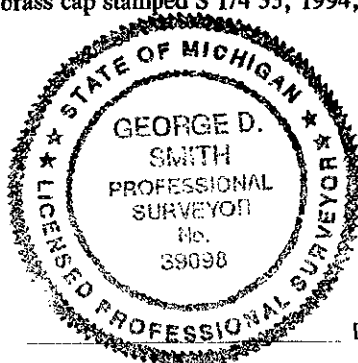

Peer Group Reviewed and Approved

Date: 11-21-94
Richard D. Wilcox
Richard D. Wilcox, Wexford County Surveyor

Signed by George D. Smith
Surveyor's Michigan License No. 39098

Date 11/17/94