

**SURVEY &
REMONUMENTATION**

APR 25 1995

COMMISSION

**LAND CORNER RECORDATION CERTIFICATE
Filing Requirement of Act 74, Mich. P.A. 1970**

RECEIVED

1994 NOV 23 PM 3:54

Linda Langhammer
WEXFORD COUNTY, MI
REGISTER OF DEEDS

For corners in

Wexford

(County)

Located In:

Corner Code #

- | | | |
|------------------------------------|---------------------------|-------------|
| 1. Public Land Survey | T <u>24N</u> R <u>10W</u> | <u>G-13</u> |
| | T _____ R _____ | _____ |
| | T _____ R _____ | _____ |
| | T _____ R _____ | _____ |
| 2. Property Controlling in Section | S _____ T _____ R _____ | _____ |
| | S _____ T _____ R _____ | _____ |
| 3. Miscellaneous Property in Sec. | S _____ T _____ R _____ | _____ |
| | S _____ T _____ R _____ | _____ |

Register of Deeds Stamp & File Number

4. Lot No. _____, Recorded Plat _____
5. Private Claims _____

	A	B	C	D	E	F	G	H	I	J	K	L	M
2	6		5		4		3		2		1		
3													
4	7		8		9		10		11		12		
5													
6	18		17		16		15		14		13		
7													
8	19		20		21		22		23		24		
9													
10	30		29		28		27		26		25		
11													
12	31		32		33		34		35		36		
13													

I, George D. Smith, in a field survey on July 12, 19 94, do hereby certify that under requirements of P.A. 74, Michigan P.A. of 1970, the corner points mentioned in lines 1 and 2 above were in conformance with regulations and rules therefore as required in the current manual of survey instructions of the United States Department of the Interior, Bureau of Land Management or by a decree of a Court of Law and/or that the corner points mentioned in lines 3, 4 and 5 above were in conformance with the rules of the Michigan Board of Land Surveyors or by a Decree of a Court of Law; established, re-established, monumented, re-monumented, recovered, found as expressed below:

NOTE: Not more than 4 corners, all in the same town and range, may be recorded on this certificate.

A. Description of original monument and accessories and/or subsequent restoration:

- G-13) 1838 GLO section post by John Brink, Deputy Surveyor, Sugar 13 N 43° E 34, Ironwood 9 N 19 1/2° E 31
- G-13) 1852 GLO subdivision of Section 4 & 3, T23N, R10W by L.S. Scranton, Deputy Surveyor, Sugar 14 S 52° W 29, Beech 6 S 5° E 12
- G-13) 1886 A.J. Teed, Liber 1, page 282, survey in Section 3, T23N, R10W, iron bar and 1 witness ok
- G-13) 1901 D.E. Teed, Liber 1, page 347, found corner, Sugar 14 N 50 1/4° W 78 links, Cedar fence post N 40 3/4° W 60
- G-13) Wexford County Road Commission witnesses (no date given), Found 1" axle shaft, 10" Apple N 45° W 55.70', 10" Apple S 45° W 106.92', 27" Maple S 45° E 72.70', 24" Maple N 65° E 90.62'
- G-13) 1964 Ostling survey for the Department of Conservation, Ref. Plan No. R-83L, Found Iron in road by County Road Commission

B. Description of corner evidence found and/or method applied in restoring or reestablishing corner:

Found railroad spike over 2" square bar ±1.2' deep, ±1' East of centerline road North-South, 3' South of centerline road East and in centerline road West. This corner is accepted as a careful and faithful perpetuation of the position of the original corner, being the Section corner common to Sections 33 and 34, T24N, R10W and Sections 4 and 3, T23N, R10W.

C. Description of monument for corner and accessories established to perpetuate locating the position of the corner:

Set 5/8" x 36" Iron with Wexford County brass cap, stamped SE 33, 1994 PS 33989, next to 2" square bar with top of cap at correct location.


- S 42° E - 110.23' - 13" Maple
- N 30° E - 69.95' - Power pole
- N 43° W - 55.92' - 8" Apple (found MSHD tag)
- S 53° W - 51.49' - Corner fence post

Peer Group Reviewed and Approved

Date: 11-21-94

Richard D. Wilcox
Richard D. Wilcox, Wexford County Surveyor

Signed by George D. Smith
Surveyor's Michigan License No. 39098

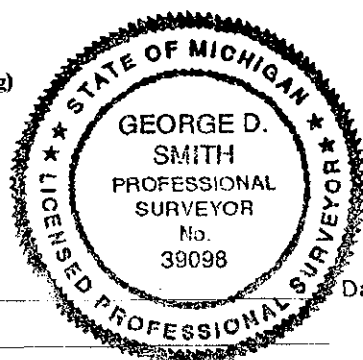

Date 11/17/94