

**SURVEY &
REMONUMENTATION**

APR 25 1995

COMMISSION

LAND CORNER RECORDATION CERTIFICATE
Filing Requirement of Act 74, Mich. P.A. 1970

RECEIVED

1994 DEC -9 PM 4: 24

For corners in

Wexford
(County)

Located In:

Corner Code #:

Leida Doughmiller
WEXFORD COUNTY, MI
REGISTER OF DEEDS

- | | | |
|------------------------------------|---------------------------|------------|
| 1. Public Land Survey | T <u>24N</u> R <u>10W</u> | <u>M-8</u> |
| | T _____ R _____ | _____ |
| | T _____ R _____ | _____ |
| | T _____ R _____ | _____ |
| 2. Property Controlling in Section | S _____ T _____ R _____ | _____ |
| | S _____ T _____ R _____ | _____ |
| 3. Miscellaneous Property in Sec. | S _____ T _____ R _____ | _____ |
| | S _____ T _____ R _____ | _____ |

Register of Deeds Stamp & File Number

4. Lot No. _____, Recorded Plat _____
5. Private Claims _____

	A	B	C	D	E	F	G	H	I	J	K	L	M
2	6	5	4	3	2								
3													
4	7	8	9	10	11	12							
5													
6	18	17	16	15	14	13							
7													
8	19	20	21	22	23	24							
9													
10	30	29	28	27	26	25							
11													
12	31	32	33	34	35	36							
13													

I, George D. Smith, in a field survey on June 14, 1994, do hereby certify that under requirements of P.A. 74, Michigan P.A. of 1970, the corner points mentioned in lines 1 and 2 above were in conformance with regulations and rules therefore as required in the current manual of survey instructions of the United States Department of the Interior, Bureau of Land Management or by a decree of a Court of Law and/or that the corner points mentioned in lines 3, 4 and 5 above were in conformance with the rules of the Michigan Board of Land Surveyors or by a Decree of a Court of Law, established, re-established, monumented, re-monumented, recovered, found as expressed below:

NOTE: Not more than 4 corners, all in the same town and range, may be recorded on this certificate.

A. Description of original monument and accessories and/or subsequent restoration:

- M-8) 1838 GLO Quarter Section post by John Brink, Deputy Surveyor, 9 Balsam N 45° W 21, 8 Balsam S 85 1/2° W 27
- M-8) 1895 A.J. Teed survey in Section 19, T24N, R9W: Set corner (no description given) on line and 1/2 distance between NE corner and SE corner, 12" Cedar S 28 1/2° E 20, 14" Tamarack N 17 3/4° E 20
- M-8) 1981 Wilcox LCRC, Liber 3, page 257: Set Wexford County monument by single proportionate measure between found NE corner of Sec. 13 and found NE corner of Sec. 25, and in centerline of North-South road, 4" Poplar S 50° W 39.35', 12" Poplar N 68° E 29.01', 6" Maple N 37° W 63.63', 6" Poplar S 66° E 30.60'

B. Description of corner evidence found and/or method applied in restoring or reestablishing corner:

Found Wexford County monument in good condition, in centerline of North-South road. This corner is accepted as a careful and faithful reestablishment of the position of the original corner, being the 1/4 corner common to Section 24, T24N, R10W and Section 19, T24N, R9W.

Peer Group Reviewed and Approved


Date: 12-9-94
Richard D. Wilcox
Richard D. Wilcox, Wexford County Surveyor

C. Description of monument for corner and accessories established to perpetuate locating the position of the corner:

Wexford County monument with aluminum cap

- S 47° W - 39.32' - 8" Poplar
- N 71° E - 28.47' - 14" Poplar
- N 40° W - 63.63' - Tri 6" Maple
- S 70° E - 30.63' - 10" Poplar

LIBER **004** PAGE **314**

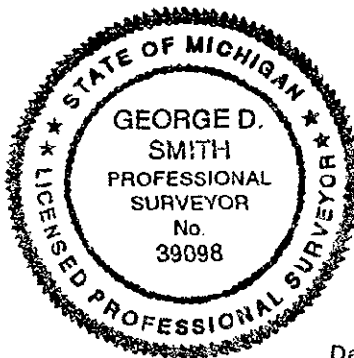

Signed by *George D. Smith*
Surveyor's Michigan License No. 39098

Date 11/29/94