

**SURVEY &
REMONUMENTATION**

APR 25 1995

RECEIVED

COMMISSION

**LAND CORNER RECORDATION CERTIFICATE
Filing Requirement of Act 74, Mich. P.A. 1970**

1994 NOV 23 PM 3:53

For corners in

Heida Loughmiller
WEXFORD COUNTY, MI
REGISTERED DEEDS

<u>Wexford</u> (County)	Located In:	Corner Code #
1. Public Land Survey	T <u>24N</u> R <u>10W</u>	<u>M-11</u>
	T _____ R _____	_____
	T _____ R _____	_____
	T _____ R _____	_____
2. Property Controlling in Section	S _____ T _____ R _____	_____
	S _____ T _____ R _____	_____
3. Miscellaneous Property in Sec.	S _____ T _____ R _____	_____
	S _____ T _____ R _____	_____
4. Lot No. _____, Recorded Plat _____		
5. Private Claims _____		

Register of Deeds Stamp & File Number

I, George D. Smith, in a field survey on June 28, 1994, do hereby certify that under requirements of P.A. 74, Michigan P.A. of 1970, the corner points mentioned in lines 1 and 2 above were in conformance with regulations and rules therefore as required in the current manual of survey instructions of the United States Department of the Interior, Bureau of Land Management or by a decree of a Court of Law and/or that the corner points mentioned in lines 3, 4 and 5 above were in conformance with the rules of the Michigan Board of Land Surveyors or by a Decree of a Court of Law, established, re-established, monumented, re-monumented, recovered, found as expressed below:

	A	B	C	D	E	F	G	H	I	J	K	L	M
2	6	5	4	3	2	1							
3													
4	7	8	9	10	11	12							
5													
6	18	17	16	15	14	13							
7													
8	19	20	21	22	23	24							
9													
10	30	29	28	27	26	25							
11													
12	31	32	33	34	35	36							
13													

NOTE: Not more than 4 corners, all in the same town and range, may be recorded on this certificate.

- A. Description of original monument and accessories and/or subsequent restoration:
- M-11) 1838 GLO Section post by John Brink, Deputy Surveyor, 14 Hemlock S 28° W 11, 14 Hemlock N 30 1/2° W 59
 - M-11) 1852 GLO Section subdivision of Section 30 & 31, T24N, R9W by V.W. Caukin, Deputy Surveyor, 12" Hemlock N 69° E 25, 10" Hemlock S 75° E 37
 - M-11) 1895 A.J. Teed survey, Liber 1, page 322: Survey in Section 30, T24N, R9W: Found stake
 - M-11) 1907 D.E. Teed survey, Liber 1, page 348: Found wood stake, Pine S 55° W 27.5 links, fence post N 43° E 65, fence post N 43 1/2° W 64.5'
 - M-11) 1975 J.L. Wilcox LCRC, Liber 2, page 744: Found 1 1/4" pipe, riser post N 45° W 44.07', corner fence post N 45° W 37.03', S 75° E guard post 40.60'
 - M-11) 1975 J.L. Wilcox Certificate of Survey, Liber 1, page 312: Found 1 1/4" pipe added Wexford County monument

B. Description of corner evidence found and/or method applied in restoring or reestablishing corner:

A. con't

- M-11) 1978 J.L. Wilcox Certificate of Survey, Liber 1, page 674
- M-11) 1980 Roser LCRC: Found well point, corner used by R.L.S. J.L. Wilcox in 1975 survey, set Wexford County monument, tele riser N 45° E 43.93, corner fence post N 45° W 37.39, 4" apple S 60° E 96.17


B.

Found Wexford County monument (in good condition) in centerline of roads North-South and East-West. This corner is accepted as a careful and faithful perpetuation of the position of the original corner, being the Section corner common to Sections 25 and 36, T24N, R10W and Sections 30 and 31, T24N, R9W.

C. Description of monument for corner and accessories established to perpetuate locating the position of the corner:

Standard Wexford County monument with aluminum cap

- N 55° E - 43.68' - Tele riser post
- S 55° E - 40.45' - Pk-nail in South side of 16" CMP
- N 40° W - 39.36' - Corner fence post
- S 19° E - 90.45' - 5" Elm
- S 60° W - 64.42' - 3" Red Pine
- S 60° E - 96.17' - 8" Apple

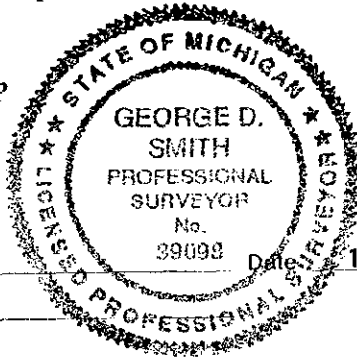

Signed by George D. Smith
Surveyor's Michigan License No. 39098

Peer Group Reviewed and Approved
Date: 11-21-94
Richard D. Wilcox
Richard D. Wilcox, Wexford County Surveyor