

**SURVEY &
REMONUMENTATION**

APR 25 1995

COMMISSION

**LAND CORNER RECORDATION CERTIFICATE
Filing Requirement of Act 74, Mich. P.A. 1970**

RECEIVED

1994 DEC -9 PM 4: 26

Linda Doughmiller
WEXFORD COUNTY, MI
REGISTER OF DEEDS

For corners in

Wexford
(County)

Located In:

Corner Code #

- | | | |
|---------------------------------------|---------------------------|-------------|
| 1. Public Land Survey | T <u>24N</u> R <u>10W</u> | <u>M-13</u> |
| | T _____ R _____ | _____ |
| | T _____ R _____ | _____ |
| | T _____ R _____ | _____ |
| 2. Property Controlling
in Section | S _____ T _____ R _____ | _____ |
| | S _____ T _____ R _____ | _____ |
| 3. Miscellaneous
Property in Sec. | S _____ T _____ R _____ | _____ |
| | S _____ T _____ R _____ | _____ |
4. Lot No. _____, Recorded Plat _____
5. Private Claims _____

Register of Deeds Stamp & File Number

I, George D. Smith, in a field survey on November 3, 19 94, do hereby certify that under requirements of P.A. 74, Michigan P.A. of 1970, the corner points mentioned in lines 1 and 2 above were in conformance with regulations and rules therefore as required in the current manual of survey instructions of the United States Department of the Interior, Bureau of Land Management or by a decree of a Court of Law and/or that the corner points mentioned in lines 3, 4 and 5 above were in conformance with the rules of the Michigan Board of Land Surveyors or by a Decree of a Court of Law, established, re-established, monumented, re-monumented, recovered, found as expressed below:

A	B	C	D	E	F	G	H	I	J	K	L	M
2	6	5	4	3	2	1						
3												
4	7	8	9	10	11	12						
5												
6	18	17	16	15	14	13						
7												
8	19	20	21	22	23	24						
9												
10	30	29	28	27	26	25						
11												
12	31	32	33	34	35	36						
13												

NOTE: Not more than 4 corners, all in the same town and range, may be recorded on this certificate.

- A. Description of original monument and accessories and/or subsequent restoration:
- M-13) 1838 GLO Township corner by John Brink, Deputy Surveyor, set post, Sugar 14 N 14° E 22, Hemlock 13 S 21° E 26
 - M-13) 1907 D.E. Teed survey, Liber 1, page 348, Found stone with cross on top and crockery around it, Poplar 12 N 52 1/2° E 67', Tele pole S 56° W 61 1/2'
 - M-13) Wexford County Road Commission (no date given), Found 1 1/4" pipe over Iron shaft, 12" Elm N 30° W 58.30', 4" Birch N 35° E 80.93', Tele pole S 45° E 39.70', 30" Poplar N 45° E 46.43', 12" Maple N 20° W 157.15', 30" Maple N 35° E 61.95', Tele pole S 45° W 36.55'
 - M-13) 1979 Wilcox LCRC, Liber 3, page 206, Found 1 1/2" pipe, set Wexford County monument, S 65° E 5" Elm 73.84', N 40° W fence corner 48.32', S 25° E tele pole 43.87', N 35° E Maple 81.31'
 - M-13) 1979 Wilcox Certificate of Survey, Liber 1, page 723, Found 1 1/2" pipe, set Wexford County monument
 - M-13) 1987 Wilcox Certificate of Survey, Liber 2, page 352, Found Wexford County monument
 - M-13) 1989 Wilcox LCRC, Liber 4, page 15, Found Wexford County monument, S 64° W 73.73' 8" Elm, N 17° W 88.40' power pole, N 28° E 81.58' 24" Maple, N 56° E 60.80' 6" Willow in clump
- B. Description of corner evidence found and/or method applied in restoring or reestablishing corner:

A. Cont'

- M-13) 1989 Wilcox Certificate of Survey, Liber 69, page 341-342, Found Wexford County monument
- M-13) 1994 Wilcox Certificate of Survey, Liber 73, page 412

B.
Found Wexford County monument (in poor condition) in centerline of road North-South and 1.5' South of centerline of East-West road. This corner is accepted as a careful and faithful perpetuation of the position of the original corner, being the Township corner common to Section 36, T24N, R10W, Section 31, T24N, R9W, Section 1, T23N, R10W and Section 6, T23N, R9W.


C. Description of monument for corner and accessories established to perpetuate locating the position of the corner:

- Set 5/8" x 36" Iron with Wexford County brass cap stamped SE 36, 1994, PS 33989
- N 14° W - 88.42' - Power pole
- N 35° W - 50.01' - Corner fence post (leaning)
- S 74° W - 73.70' - 10" Elm stump
- N 70° E - 60.86' - 14" Willow
- S 33° E - 46.70' - 1/2" Iron with cap #14102 at Southwest corner of telephone riser
- North - 4.60' - Hex. bolt

Peer Group Reviewed and Approved

Date: 12-2-94
Richard D. Wilcox
Richard D. Wilcox, Wexford County Surveyor

LIBER 004 PAGE 323

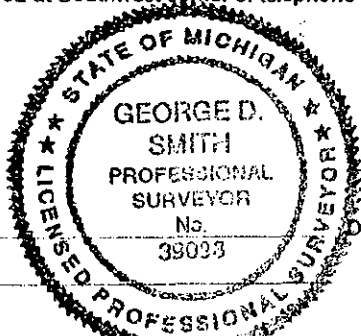

Signed by *George D. Smith*
Surveyor's Michigan License No. 39098

Date 11/29/94