


# LAND CORNER RECORDATION CERTIFICATE

Filing Requirement of Act 74, Mich. PA 1970

For Corners In: Wexford (County)	Located In	Corner Code #
1. Public Land Survey	T <u>24N</u> R <u>10W</u> E <u>6</u>	
	T _____ R _____	
2. Property Controlling in Section	S _____ T _____ R _____	
	S _____ T _____ R _____	
3. Miscellaneous Property in Section	S _____ T _____ R _____	
	S _____ T _____ R _____	
4. Lot No: _____	Recorded Plat: _____	
5. Private Claims: _____		

Register of Deeds Stamp & File Number

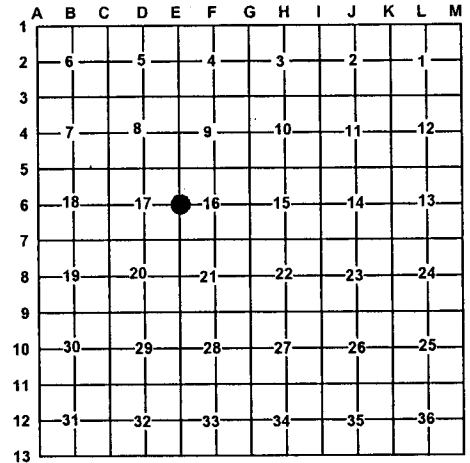

I, Craig W. McVean, in a field survey on June 28, 2006 do hereby state that under requirements of PA 74, Michigan PA of 1970, the corner points mentioned in lines 1 and 2 above were in conformance with regulations and rules therefore as required in the current manual of survey instructions of the United States Department of the Interior, Bureau of Land Management or by a decree of a Court of Law and/or that the corner points mentioned in lines 3, 4 and 5 above were in conformance with the rules of the Michigan Board of Land Surveyors or by a Decree of a Court of Law; established, re-established, monumented, recovered, found as expressed below:

**NOTE: Not more than 2 corners, all in the same town and range, may be recorded on this certificate.**

**A. Description of original monument and accessories and/or subsequent restoration:**

- |  |  |
|--|--|
| <p><u>E6</u> – GLO – Set Beech post for ¼ post – L. S. Scranton – 1852<br/>                 W. Pine 36" N45°W 3 L.<br/>                 W. Pine 24" S79°E 15 L.<br/>                 - CSR - D. Teed – 1901 – Fd. both wit. Badly burnt and remains of original stake. Remarkd W. Pine 24" lower down but W. Pine 36" was plain enough – Set pine stake.<br/>                 W. Pine 18" N83½°E 42<br/>                 W. Pine 24" S78°E 13 ½<br/>                 W. Pine 36" N45°W 3<br/>                 - Fargo – 1913 – Fd. old stake and remains of both U.S. wits. with hacks of bottom. Set iron and crockery mon.</p> | <p>36" W. Pine stub N34° 30'W 3 ¼ L.<br/>                 24" WPS S76° 15' W 13 ¼ L.<br/>                 24" WPS N83° 15' E 42 L.<br/>                 - Alderman – fd. 2 old wits. – 1900's<br/>                 - M. Schaaf – 1937 – both stps. intact.<br/>                 WPS 32" N53°E 201 L.<br/>                 Granite Stone 4" x 5 ½' S45°W 274 to center<br/>                 - Rec. Survey – L. 1, p. 860 – E. Farrier – 1980<br/>                 Fd. 1 ¼" x 4' pipe<br/>                 N30°W 5" R. Pine 16.00'<br/>                 S50°E 7" R. Pine 8.80<br/>                 S70°W 7" R. Pine 20.25'<br/>                 S50° 7" R. Pine 7.90</p> |
|--|--|

**B. Description of corner evidence found and/or method applied in restoring or re-establishing corner:**

E6 – ¼ Corner between Sections 17 & 16, T24N, R10W - Fd. 1 ¼" x 4' pipe, bent, with can of concrete at base. Fd. two butter dishes (crockery) at base. Fd. remains of the GLO and Teed's SE BT, Fargo's SW BT and both of Schaaf BT's; all in agreement w/ 1 ¼" pipe. Cut off bent portion of pipe, now 22" long, reset with 5/8" x 34" rebar set inside with 2" Aluminum stamped cap. Placed ring of cobblestones. In Red Pine plantation. The 2" Aluminum cap on 5/8" x 34" rebar inside 1 ¼" x 22" pipe is accepted as a careful and faithful perpetuation of the position of the original corner.

**C. Description of monument for corner and accessories established to perpetuate locating the position of the corner:**

E6 – 2" Stamped Aluminum Cap on 5/8" x 34" rebar set inside a 1 ¼" x 22" long I.P. with concrete on bottom. Placed ring of cobblestone.  
 N34°W 15.94' to set N & T in SW side 10" R. Pine scribed 'XBT' (EF)  
 N24°E 14.46' to set N & T in W. side 14" R. Pine scribed 'XBT'  
 S46°E 8.78' to set N & T in SW side 13" R. Pine scribed 'XBT' (EF)  
 S45°W 7.88' to set N & T in SE side 12" R. Pine scribed 'XBT' (EF)  
 S32°W 181.07' to chiseled 'X' in top of 3' x 5' long granite boulder 2± above ground (MS)  
 Set Blue Carsonite Post 1' North

Signed by: Craig W. McVean  
 Surveyor's Michigan License No.: 39088

Date: 6/7/2006

