


**LAND CORNER RECORDATION CERTIFICATE**  
Filing Requirement of Act 74, Mich. PA 1970

For Corners In: <u>Wexford</u> (County)	Located In	Corner Code #
1. Public Land Survey	T <u>24N</u> R <u>10W</u> <u>E5</u>	
	T _____ R _____	
2. Property Controlling in Section	S _____ T _____ R _____	
	S _____ T _____ R _____	
3. Miscellaneous Property in Section	S _____ T _____ R _____	
	S _____ T _____ R _____	
4. Lot No: _____	Recorded Plat: _____	
5. Private Claims: _____		

Register of Deeds Stamp & File Number

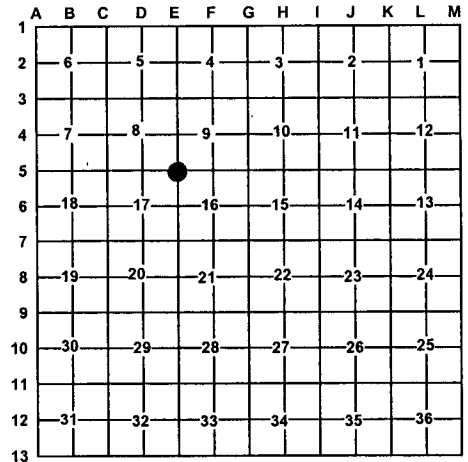

I, Craig W. McVean, in a field survey on Aug. 16, 2005 do hereby state that under requirements of PA 74, Michigan PA of 1970, the corner points mentioned in lines 1 and 2 above were in conformance with regulations and rules therefore as required in the current manual of survey instructions of the United States Department of the Interior, Bureau of Land Management or by a decree of a Court of Law and/or that the corner points mentioned in lines 3, 4 and 5 above were in conformance with the rules of the Michigan Board of Land Surveyors or by a Decree of a Court of Law; established, re-established, monumented, recovered, found as expressed below:

**NOTE: Not more than 2 corners, all in the same town and range, may be recorded on this certificate.**

A. Description of original monument and accessories and/or subsequent restoration:

- E5 – GLO – Set Ash Post – L. S. Scranton – 1852  
B. Ash 16" S47°E 18 L.  
Lynn 10" N11°W 12 L.
- CSR – FBK. 65, p. 96-97 & L. 1, p. 122 – D. E. Teed - 1901  
Fd. remains of original stake and both Gov't Wit. Mark on Lynn grown over. Sugar 14" S14°W 30 L; Cedar 12" S23¾°E 17; Sugar 8" N75¼°E 21.
- Alderman – 1900's – 1 old wit
- Fargo Eng. – 1913 – Fd. Old stake. Alderman's beside it and remains of both old wits. Set iron post & crockery. Cedar 16" S77½°W 61½; Cedar 14" S24¼°E 17; Sugar 18" S14°W 30
- M. Schaaf – 1937 – Fd. clp. of Lynn sprouts. Fd. 24" WPS N8°23'E 383 L. CP Co. correct here.
- H. Bruning Notes – 1964 – I. P. and crockery (butter patty)
- Helsel's Sub. – L. 5 of plats, p. 150 – H. R. Bruning – 1964 – ½" x 36" iron rod encased in 4" Concrete cylinder.
- LCRC – L. 1, p. 193 – J. L. Wilcox – 1972 - fd. conc. Mon.; N70°W 10" Basswood 41.37'; N20°E 4" Spruce 23.88'; N85°E P. Pole 3.54'
- WCRC – Conc. Mon. – W & E 1972 – Same wit's as Wilcox
- LCRC – L. 3, p. 360 – C. F. Roser – 1986  
Fd. Round Conc. Mon. Added Cedar post with loc. tag 7" Ash N45°E 51.34'; P.Pole N82°E 3.54'; 12" Basswood N74°W 41.37'; 10" Ash S12°E 16.89'; E. Bank Manistee River West 65'±

B. Description of corner evidence found and/or method applied in restoring or re-establishing corner:

- E5 – Sec. Cor. common to Sec. 8, 9, 16 & 17 – Fd. 4" Conc. Mon. with ½" iron per plat, Wilcox & Roser. At S73°W 41.2' from mon. to centerline remains 16" Cedar stp. which is Fargo's old wit. Also fd. 12" Cedar stp. S25°E 14.7' but appears to be moved. Bruning apparently replaced Fargo pipe with plat mon. in 1964. Conc. Mon. accepted as a careful and faithful perpetuation of the position of the original corner.

C. Description of monument for corner and accessories established to perpetuate locating the position of the corner:

- E5 – Epoxied stamped 2" Alum. Cap on fd. Conc. Mon.  
Set Blue Carsonite Post 1' SE  
N88°E 3.55' to fd. N & T in S. side P.P. (JLW, CFR)  
N45°E 51.39' to set N & T in SE side 11" Ash (CFR)  
S13°E 16.91' to fd. nail in E. side 13" Ash (CFR)  
West 59.40' (58.95' – P) to fd. leaning conc. plat Mon. – on E. Bank River – Add Blue Carsonite Post 1' S

Signed by: Craig W. McVean  
Surveyor's Michigan License No.: 39088

Date: 6/7/2006

