

LAND CORNER RECORDATION CERTIFICATE
Filing Requirement of Act 74, Mich. PA 1970

For Corners In: Wexford Located In _____ Corner Code # _____
(County)

| | | | | | |
|--------------------------------------|---|------------|---|------------|-----------|
| 1. Public Land Survey | T | <u>24N</u> | R | <u>10W</u> | <u>F5</u> |
| | T | _____ | R | _____ | _____ |
| 2. Property Controlling in Section | S | _____ | T | _____ | R |
| | S | _____ | T | _____ | R |
| 3. Miscellaneous Property in Section | S | _____ | T | _____ | R |
| | S | _____ | T | _____ | R |


4. Lot No: _____ Recorded Plat: _____

5. Private Claims: _____

I, Craig W. McVean, in a field survey on June 22, 2005 do hereby state that under requirements of PA 74, Michigan PA of 1970, the corner points mentioned in lines 1 and 2 above were in conformance with regulations and rules therefore as required in the current manual of survey instructions of the United States Department of the Interior, Bureau of Land Management or by a decree of a Court of Law and/or that the corner points mentioned in lines 3, 4 and 5 above were in conformance with the rules of the Michigan Board of Land Surveyors or by a Decree of a Court of Law; established, re-established, monumented, recovered, found as expressed below:

NOTE: Not more than 2 corners, all in the same town and range, may be recorded on this certificate.

Register of Deeds Stamp & File Number

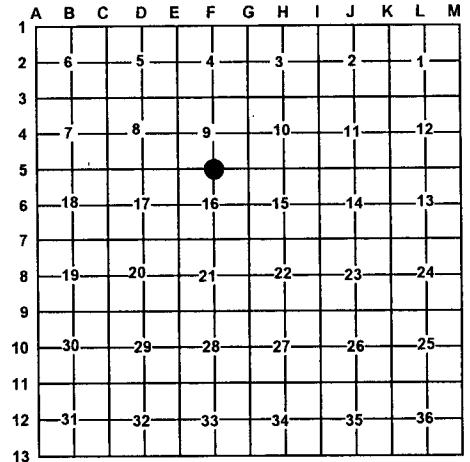

A. Description of original monument and accessories and/or subsequent restoration:

F5 - GLO - Set Hemlock Post - 1852 - L. S. Scranton
Hemlock 15" S11°E 10 L.
Hemlock 8" N52°W 27 L.
- Alderman - Fd. no old wits. - 1900's
PS 14" N75°E 33 L.
- Fargo - 1913 - No US evidence, set iron post & crockery - SP
Corner in Rd. N-S
WPS 18" N56½°E 88 ½ L.
WPS 18" S41 ¾° E 82
WPS 30" N50°W 87 ½ L.

- LCRC - L. 2, p. 760 - C. F. Roser - 1975
Fd. Fargo pipe in W'y wheel track of N-S Trail Rd.
Fit remains of 3 Fargo wits. Added standard Wex. Co. Mon.
18" Oak S40°W 77.2'
18" Oak S33°E 76.4'
10" Oak N37°E 132.2'
Set Cedar post with Loc. tag 33' E.
- Rec Survey - L. 1, p. 860 - E. Farrier - 1980
Fd. DNR Mon
N33°W 8" R. Pine 70.0'
N70°W 7" R. Pine 46.2'
S43°W 7" R. Pine 79.0'

B. Description of corner evidence found and/or method applied in restoring or re-establishing corner:

F5 - ¼ Corner between Sections 9 & 16, T24N, R10W - Fd. Wexford County Alum. monument, down 0.8'. 6± W. of Centerline N-S 2-track. Found Fargo's NE & NW BT's in agreement with Mon. and also two C. F. Roser wits. Wexford County Aluminum monument is accepted as a careful and faithful reestablishment of the position of the original corner.

C. Description of monument for corner and accessories established to perpetuate locating the position of the corner:

F5 - Wexford County Standard Aluminum Monument
N26°E 49.43' to set n & T in NW side 7" Maple clp. of 6.
S78°E 38.65' to set N & T in N. side 6" R. Pine
S24°W 21.47' to set N & T in W. side 14" Oak
N80°W 15.78' to set N & T in S. side 9" Oak
S34°E 77.45' to set N & T in SW side 27" Twin Oak (CFR)
N37°E 130.94' to set N & T in NW side triple 19" Oak (CFR)
Set Blue Carsonite Post with Location tag 33' E. next to fd. Cedar Post



Signed by: Craig W. McVean
Surveyor's Michigan License No.: 39088

Date: 6/7/2006