


**LAND CORNER RECORDATION CERTIFICATE**  
Filing Requirement of Act 74, Mich. PA 1970

For Corners In: Wexford (County)	Located In	Corner Code #
1. Public Land Survey	T <u>24N</u> R <u>10W</u> <u>G5</u>	
2. Property Controlling in Section	T _____ R _____	
3. Miscellaneous Property in Section	S _____ T _____ R _____	
4. Lot No: _____	Recorded Plat: _____	
5. Private Claims: _____		

Register of Deeds Stamp & File Number

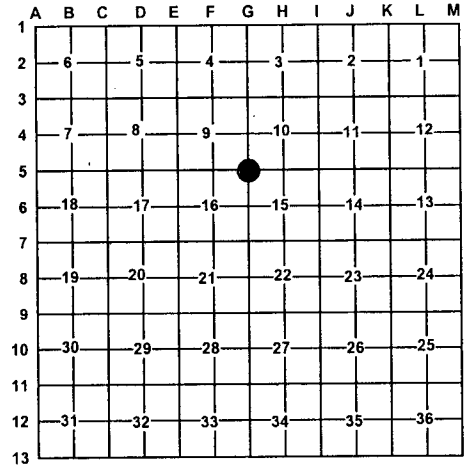

I, Craig W. McVean, in a field survey on Sept. 8, 2005 do hereby state that under requirements of PA 74, Michigan PA of 1970, the corner points mentioned in lines 1 and 2 above were in conformance with regulations and rules therefore as required in the current manual of survey instructions of the United States Department of the Interior, Bureau of Land Management or by a decree of a Court of Law and/or that the corner points mentioned in lines 3, 4 and 5 above were in conformance with the rules of the Michigan Board of Land Surveyors or by a Decree of a Court of Law; established, re-established, monumented, recovered, found as expressed below:

**NOTE: Not more than 2 corners, all in the same town and range, may be recorded on this certificate.**

A. Description of original monument and accessories and/or subsequent restoration:

- G5 – GLO – Set Hemlock post – L. S. Scanton – 1852  
W. Pine 30" N55°W 54 L.  
Sugar 15" S40°E 9 L.  
- Fargo Eng. – 1913 – Fd. both US Wit's. PS w/hack at bottom plain. Fd. roots of Sugar. Set iron post and crockery. WPS 36" S19°W 167 L.; WPS 22" N1°E 84
- M. Schaaf – 1937 – Notes corner  
- LCRC – L. 3, p. 192 – J. L. Wilcox  
Set Wexford Co. Mon. by Double Prop. To Fargo;  
N14°E 154.81' P.P.' S43°W 114.80' – 12" W. Pine;  
N57°W 125.60' – 30" R. Oak; S13°W 18.82' – RR spike  
- LCRC – L. 6, p. 253 – J. D. Geers – 2004 - Fd. Wex. Co. Mon.  
and add Mon. Box – 5.2' E. of centerline 31 Rd.; N16°E 154.82'  
Fd. nail in P.P.; N57°W 125.53' Fd. nail in 36" Oak; S74°W 83.59'  
Fd. nail in 12" W. Pine; S76°E 43.53' set nail in 4" Cottonwood;  
N45°E 74.62' set nail in 7" Poplar; S44°W 72.59' Set nail in 7"  
W. Pine.

B. Description of corner evidence found and/or method applied in restoring or re-establishing corner:

G5 – Sec. Corner common to Sec. 9, 10, 15 & 16 – Fd. Wexford Co. Alum. Mon. in fair condition in Mon. Box. 5.5' E. of centerline N-S Bit. Rd. Measured following dimensions North 2642.58' vs. 2641.5 – FE to 'G4'. West 2639.91' vs. 2638.43' – FE to 'F5'; South 2637.78' vs. 2637.36' – FE to 'G6' and East 2592.39' vs. 2588.44' – FE to 'H5' and East 5174.93' vs. 5176.88' – FE to 'I-5'. Fargo and GLO wit's gone. New Bit. Rd. here so no excavation done. Position of Wexford Co. Mon by Wilcox seems reasonable so accepted Wexford Co. Mon. as the best available evidence of the position of the original corner.

C. Description of monument for corner and accessories established to perpetuate locating the position of the corner:

G5 – Wexford Co. Alum. Mon. in Mon. Box.  
West 33.01' to set 2" Alum. Cap on 5/8" x 34" rebar – on-line with Blue Carsonite Post with loc. tag.  
S80°E 43.55' to fd. N & T in N. side 4" Poplar (JDG)  
N37°E 74.55' to fd. N & T in NW side 8" Poplar (JDG)  
N10°E 154.80' to fd. N & T in NW side P.P. (JLW, JDG)  
N63°W 125.54' to fd. nail in NE side 40" Oak (JLW, JDG)  
S71°W 83.60' fd. nail in SE side 12" W. Pine (JDG)  
S42°W 72.53' to set N & T in SE side 11" W. Pine (JDG)

Signed by Craig W. McVean  
Surveyor's Michigan License No.: 39088

Date: 6/7/2006

