

LAND CORNER RECORDATION CERTIFICATE

Filing Requirement of Act 74, Mich. PA 1970

For Corners In: _____ Located In _____ Corner Code # _____
 Wexford (County)


- | | | | | | |
|--------------------------------------|---|-----|---|-----|----|
| 1. Public Land Survey | T | 24N | R | 10W | H5 |
| | T | | R | | |
| 2. Property Controlling in Section | S | | R | | |
| | S | | R | | |
| 3. Miscellaneous Property in Section | S | | R | | |
| | S | | R | | |

Register of Deeds Stamp & File Number

4. Lot No: _____ Recorded Plat: _____
5. Private Claims: _____

I, Craig W. McVean, in a field survey on June 16, 2005 do hereby state that under requirements of PA 74, Michigan PA of 1970, the corner points mentioned in lines 1 and 2 above were in conformance with regulations and rules therefore as required in the current manual of survey instructions of the United States Department of the Interior, Bureau of Land Management or by a decree of a Court of Law and/or that the corner points mentioned in lines 3, 4 and 5 above were in conformance with the rules of the Michigan Board of Land Surveyors or by a Decree of a Court of Law; established, re-established, monumented, recovered, found as expressed below:

NOTE: Not more than 2 corners, all in the same town and range, may be recorded on this certificate.

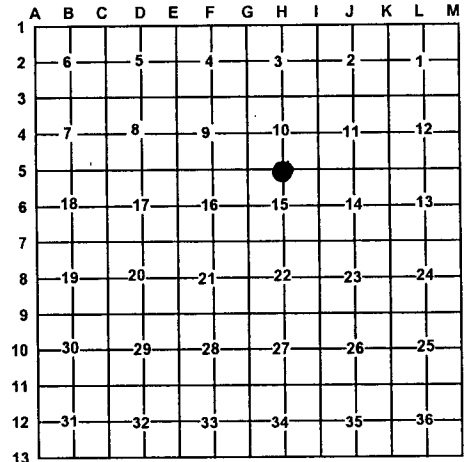

A. Description of original monument and accessories and/or subsequent restoration:

- | | |
|---|---|
| <p><u>H5</u> – GLO – Set Hemlock Post – L. S. Scranton – 1852
 Yellow Birch 10" S48°W 15 L.
 Beech 8" N14°E 18 L.
 - Fargo – 1913 – No U. S. evidence – set pipe and crockery.
 Prorated distance.
 Cedar 18" S45°E 1.06¼
 Poplar 4" N52°E 0.54
 - LCRC – L. 3, p. 192 – J. L. Wilcox
 Fd. Fargo – Set Wexford Co. Mon.
 East 2" Poplar 12.20';</p> | <p>S32°E 8" Maple 37.65;
 S62°W 8" Maple 33.33;
 N45°W 16" Birch 15.62;</p> |
|---|---|

B. Description of corner evidence found and/or method applied in restoring or re-establishing corner:

H5 – ¼ Corner common to sections 10 & 15, T24N, R10W - Fd. Wexford County Aluminum monument at North edge of overgrown E-W 2-track road. Dug around and fd. ¾" pipe on E. side monument. No GLO evidence. Found Fargo cedar wit. to SE but tipped up. Wexford County monument at Fargo position is accepted as a careful and faithful re-establishment of the position of the original corner.

C. Description of monument for corner and accessories established to perpetuate locating the position of the corner:

H5 – Wexford County Aluminum Monument.
 N40°W 15.70' to found Nail in NE side 20" W. Birch (JLW)
 S70°W 42.29' to found Nail in N side 14" triple R. Maple
 S18°E 37.71' to found Nail in NE side 15" R. Maple (JLW)
 N74°E 7.31' to found Nail in SE side 5" R. Maple
 N14°E 46.07' to set N & T in E. side 14" R. Maple
 Set Blue Carsonite Post with Loc. Tag 1' North



Signed by: Craig W. McVean
 Surveyor's Michigan License No.: 39088

Date: 6/7/2006