

# LAND CORNER RECORDATION CERTIFICATE

Filing Requirement of Act 74, Mich. PA 1970

For Corners In: \_\_\_\_\_ Located In \_\_\_\_\_ Corner Code # \_\_\_\_\_  
 Wexford \_\_\_\_\_  
 (County)

- |                                      |   |     |   |     |     |  |
|--------------------------------------|---|-----|---|-----|-----|--|
| 1. Public Land Survey                | T | 24N | R | 10W | I-5 |  |
|                                      | T |     | R |     |     |  |
| 2. Property Controlling in Section   | S | T   | R |     |     |  |
|                                      | S | T   | R |     |     |  |
| 3. Miscellaneous Property in Section | S | T   | R |     |     |  |
|                                      | S | T   | R |     |     |  |


4. Lot No: \_\_\_\_\_ Recorded Plat: \_\_\_\_\_

5. Private Claims: \_\_\_\_\_

I, Craig W. McVean, in a field survey on June 28, 2005 do hereby state that under requirements of PA 74, Michigan PA of 1970, the corner points mentioned in lines 1 and 2 above were in conformance with regulations and rules therefore as required in the current manual of survey instructions of the United States Department of the Interior, Bureau of Land Management or by a decree of a Court of Law and/or that the corner points mentioned in lines 3, 4 and 5 above were in conformance with the rules of the Michigan Board of Land Surveyors or by a Decree of a Court of Law; established, re-established, monumented, recovered, found as expressed below:

**NOTE: Not more than 2 corners, all in the same town and range, may be recorded on this certificate.**

Register of Deeds Stamp & File Number

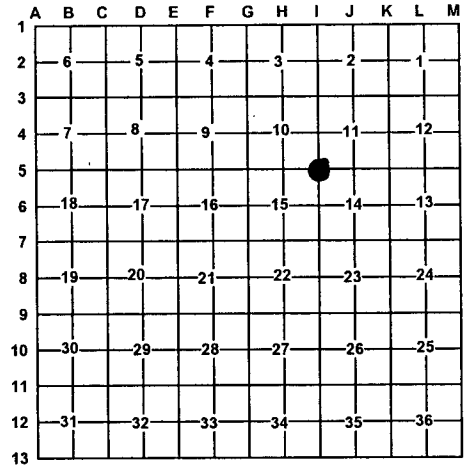

**A. Description of original monument and accessories and/or subsequent restoration:**

- I-5 – GLO – Set Hemlock Post – L. S. Scranton – 1852  
 W. Pine 16" S19°W 6 L.  
 W. Pine 18" N66°E 29 L.
- CSR – Teed – Fd. stake and both Gov. wits. W. Pine to SW marks plain. Upper Marks of W. Pine NE plain.  
 W. Pine 16" S19°W 40 L.; W. Pine 16" S87½°E 49
- CSR – Bk. 2, p. 40 – E. E. Sours – 1913 – Stake set by dam surveyors

- Fargo – 1913 – Fd. stake in center rds. S & W. Accepted Fd. W. Pine with scribe marks hauled to side of road.  
 WPS 24" S74°E 47 L.  
 WPS 16" N23°W 57½ L.
- WCRC – 1965 – 12" spike in ¾" pipe – 12" deep  
 Blazed tree NW 46.6' fd; Blazed tree SW 60.9';  
 Blazed stump SE 78.90'

**B. Description of corner evidence found and/or method applied in restoring or re-establishing corner:**

I-5 – Section Corner common to Sections 10, 11, 14 & 15 of T24N, R10W - Fd. ¾" x 2.5' long iron pipe w/ hooked end w/ crockery with a ½" x 24" rebar with CP – DAA Cap #21265 on NE side of pipe in gravel road intersection, down 1.0'. Fits remains of Wex. Co. Rd. Comm. Wits. to NW (Fd. Poplar Stp. w/ tag) & SE (Fd. 24" PS). All old GLO, CSR and Fargo wits. gone. In centerline E-W gravel rd. and 12± East of N-S gravel rd. on curve. ¾" Fargo pipe accepted as the best available evidence of the position of the original corner.

**C. Description of monument for corner and accessories established to perpetuate locating the position of the corner:**

I-5 – Replaced ¾" iron pipe and CIR w/ 4" Brass DOC (DNR) monument on 1" x 36" galv. iron pipe encased with coffee can of concrete. Placed fd. butter dish crockery at base mon. as memorial.  
 N11°E 37.02' to set N & T at Fd. nail in E. side 7" twin Black Cherry  
 S63°E 53.54' to set N & T in N. side 15" White Pine scribed 'XBT'  
 S41°E 69.18' to set N & T in SW side 18" White Pine scribed 'XBT'  
 S51°W 77.34' to set N & T in SE side 12" twin R. Maple scribed 'XBT'  
 Set Blue Carsonite Post w/ loc. tag N45°E 40'



Signed by: Craig W. McVean  
 Surveyor's Michigan License No.: 39088

Date: 6/7/2006