

LAND CORNER RECORDATION CERTIFICATE
Filing Requirement of Act 74, Mich. PA 1970

For Corners In: _____
Wexford _____
(County) _____

Located In _____ Corner Code # _____

- | | | | |
|--------------------------------------|-------------|--------------|------------------------|
| 1. Public Land Survey | T _____ | R _____ | _____ |
| | T _____ | R _____ | _____ |
| 2. Property Controlling in Section | S <u>10</u> | T <u>24N</u> | R <u>10W</u> <u>10</u> |
| | S <u>16</u> | T <u>24N</u> | R <u>10W</u> <u>6</u> |
| 3. Miscellaneous Property in Section | S _____ | T _____ | R _____ |
| | S _____ | T _____ | R _____ |


4. Lot No: _____ Recorded Plat: _____

5. Private Claims: _____

I, Craig W. McVean, in a field survey on Sept. 8, 2005 do hereby state that under requirements of PA 74, Michigan PA of 1970, the corner points mentioned in lines 1 and 2 above were in conformance with regulations and rules therefore as required in the current manual of survey instructions of the United States Department of the Interior, Bureau of Land Management or by a decree of a Court of Law and/or that the corner points mentioned in lines 3, 4 and 5 above were in conformance with the rules of the Michigan Board of Land Surveyors or by a Decree of a Court of Law; established, re-established, monumented, recovered, found as expressed below:

NOTE: Not more than 2 corners, all in the same town and range, may be recorded on this certificate.

Register of Deeds Stamp & File Number

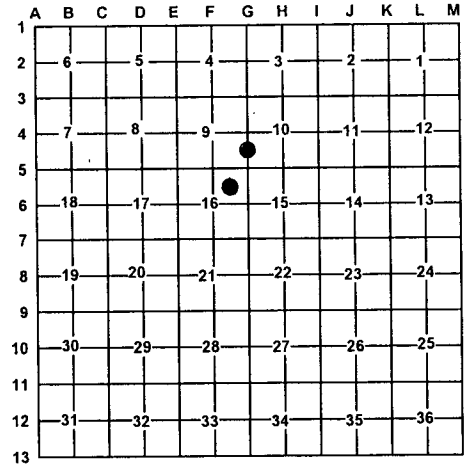

A. Description of original monument and accessories and/or subsequent restoration:

- | | |
|---|--|
| <u>10</u> – CSR – L. 2, p. 44 – E. E. Sours – 1913
Rd. Survey – W. Pine Stp. 16" S81½°E 37.8';
W. Pine Stp. 16" N85°W 56½ | <u>6</u> – Rec. Survey – L. 1, p. 860 – E. Farrier
- 1980 – Set ½" rod. |
|---|--|

B. Description of corner evidence found and/or method applied in restoring or re-establishing corner:

- | | |
|--|--|
| <u>10</u> – S 1/16 corner common to Sec. 9 & 10 – No evidence of Sours BT's or monument. Set stamped 2" Alum. Cap on 5/8" x 24" iron rebar per Standard BLM procedure. In centerline of N-S Bit. Rd. | <u>6</u> – NE 1/16, Sec. 16 – Fd. ½" capped iron rod #24594. ½" CIR accepted as the best available evidence of the position of the corner. |
|--|--|

C. Description of monument for corner and accessories established to perpetuate locating the position of the corner:

- | | |
|--|--|
| <u>10</u> – Stamped 2" Alum. Cap on 5/8" x 34" rebar
N33°W 87.34' to set N & T in SW side 12" W. Pine
S81°E 51.56' to set N & T in N. side 17" R. Pine
S59°E 58.36' to set N & T in SW side 8" R. Pine
S68°W 69.67' to set N & T in N. side 7" R. Maple
East 33' to set Blue Carsonite Post with loc. tag | <u>6</u> – ½" CIR # 24594
Set Blue Carsonite Post with loc. tag 1' S.
S52°E 15.78' to set N & T in NE side Tri. 9" R. Maple
S26°W 24.28' to set N & T in SE side 4" Spruce
N56°W 21.42' to set N & T in SW side 6" W. Pine
N12°W 13.92' to set N & T in SW side Tri. 10" R. Maple |
|--|--|

Signed by: Craig W. McVean
Surveyor's Michigan License No.: 39088

Date: 6/7/2006

