

Wexford Co. ~ Hanover Twp.

LAND CORNER RECORDATION CERTIFICATE
FILING REQUIREMENT OF ACT 74, MICH. P.A.1970

Table with 3 columns: FOR CORNERS OF--, LOCATED IN--, CORNER CODE NUMBER. Rows include Public Land Survey, Property Controlling in Section, Miscellaneous Property in Section, Lot No., and Private Claims.

REGISTER OF DEEDS STAMP AND FILING NUMBER

I, Carl F. Roser do hereby certify that under requirements of P.A. 74, Michigan P.A. of 1970, the corner points mentioned in lines 1 and 2 above (identified with circles on index code diagram - over) were, in a field survey on September 20, 1973, established, re-established, monumented, re-monumented, recovered or restored as expressed below and in conformance with regulations and rules therefore as required in the current manual of survey instructions of the United States Department of the Interior, Bureau of Land Management or by a decree of a court of law.

C. (continued)

- Set 1" x 6' pipe & cedar post w/loc. tag
12" Cedar Due E 91.16'
7" Cedar S35W 59.08'

B. Description of corner evidence found and/or method applied in restoring or re-establishing corner:

- H-11 - Recovered 'Fargo' pipe and one witness.
H-13 - Restored corner per DeVoe & Alderman Survey's of record, 1896 & 1899. Corner position fits 1/8 line fn. to W. and split of 66' WD E-W Rd. ROW fns. Fd. 3/4" Fargo Pipe (buried 30") S48°40'W 23.5' from Cor. as restored. Fargo set their cor. by S. R. in 1913. Did not accept Fargo Cor.
I-11 - Recovered 'Fargo' pipe from remains of one witness SE.
12 - Established corner per standard BLM instructions.

C. Description of monument for corner and accessories established to perpetuate locating the position of the corner:

Table with 3 columns: H-11, H-13, I-11. Lists monument details for each corner, including pipe, guard post, and various trees with bearings and distances.

(continued)

SIGNED BY Carl F. Roser DATE 11-7-73

SURVEYOR'S MICHIGAN REGISTRATION NO. 12028

FOR STATE AND UNITED STATES AGENCIES:

SIGNED BY CHIEF OF SURVEY PARTY


APPROVED AND SIGNED BY MICHIGAN REGISTERED LAND SURVEYOR



SURVEYOR'S MICHIGAN REGISTRATION NO.


**CORNER NUMBERING CODE DIAGRAMS FOR IDENTIFYING LAND CORNER  
RECORDATIONS AND INDEXING**

FOR PUBLIC LAND SURVEY CORNERS IN THE  
T. 24 N., R. 11 W. (MENTIONED OVER)

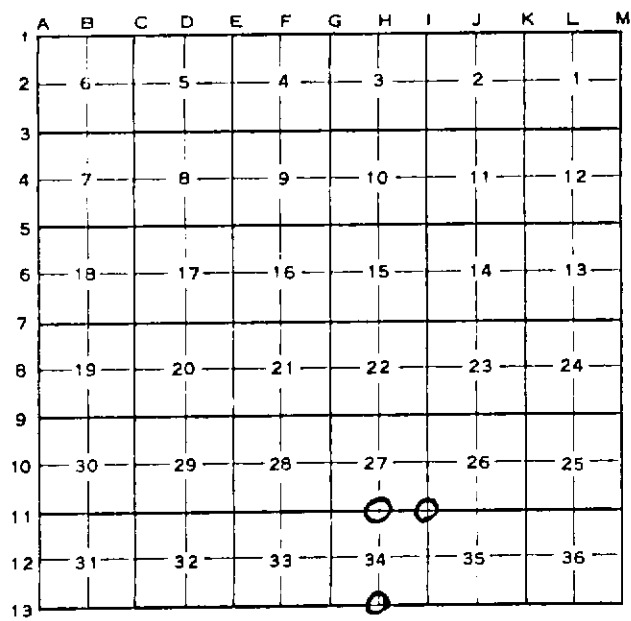

Apply letter prefix for corner points encircled above  
for identifying corner recordation numbers over.

FOR PROPERTY CONTROLLING AND MISC.  
PROPERTY CORNERS WITHIN THE SECTION  
(MENTIONED OVER AND EXCLUDE LOT CORNER)

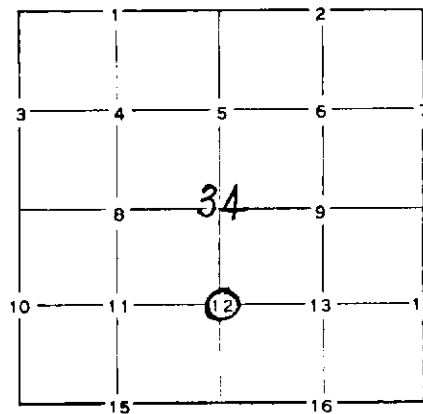

1. Above coded numbers are positioned on 1/16 fractional lines of the section.
2. Township corner code numbers shall be applied to corners of above typical section not numbered.
3. Miscellaneous property corners within a section, located at points other than numbered above, shall be referenced to at least two of above corner code numbers.
4. Private claim corners to be tied to rectangular land corners if possible - sketch required below.

**EXPLANATORY SKETCH IF NECESSARY -- BELOW**

