

Wexford Co. ~ Hanover Twp.

LAND CORNER RECORDATION CERTIFICATE
FILING REQUIREMENT OF ACT 74, MICH. P.A.1970

Table with columns: FOR CORNERS OF--, LOCATED IN--, CORNER CODE NUMBER. Rows include Public Land Survey, Property Controlling in Section, Miscellaneous Property in Section, Lot No., and Private Claims.

REGISTER OF DEEDS STAMP AND FILING NUMBER

I, Carl F. Roser do hereby certify that under requirements of P.A. 74, Michigan P.A. of 1970, the corner points mentioned in lines 1 and 2 above (identified with circles on index code diagram - over) were, in a field survey on October 18, 1973, established, re-established, monumented, re-monumented, recovered or restored as expressed below and in conformance with regulations and rules therefore as required in the current manual of survey instructions of the United States Department of the Interior, Bureau of Land Management or by a decree of a court of law.

C. (continued)

15
Set 1" x 36" pipe (buried)
Ctr. E-W Gravel Rd. Due S 4'
9" Maple N63W 68.5'
6" Maple S41W 46.1'
10" B. Cherry S46E 61.3'

15 (continued)
Fn. N & S from Rd. ROW Due W 3'
Set ced. post w/loc. tag Due N 33'

B. Description of corner evidence found and/or method applied in restoring or re-establishing corner:

- K-12 Recovered 'Fargo' corner by digging and finding butter dish.
L-11 Recovered 'Fargo' pipe and remains of Witness S.W.
L-13 Found Wilcox and Erickson of record.
15 Established corner equidistant and on line between found corners to east & west.

C. Description of monument for corner and accessories established to perpetuate locating the position of the corner:

Table with columns for corner codes K-12, L-11, L-13 and descriptions of monuments and accessories for each.

SIGNED BY Carl F. Roser DATE 11-7-73

SURVEYOR'S MICHIGAN REGISTRATION NO. 12028

FOR STATE AND UNITED STATES AGENCIES:

SIGNED BY CHIEF OF SURVEY PARTY

APPROVED AND SIGNED BY MICHIGAN REGISTERED LAND SURVEYOR




SURVEYOR'S MICHIGAN REGISTRATION NO.

Form No. MLM735

MICH. REG. NO. 12028


CORNER NUMBERING CODE DIAGRAMS FOR IDENTIFYING LAND CORNER RECORDATIONS AND INDEXING

FOR PUBLIC LAND SURVEY CORNERS IN THE
T. 24_N, R. 11_W. (MENTIONED OVER)

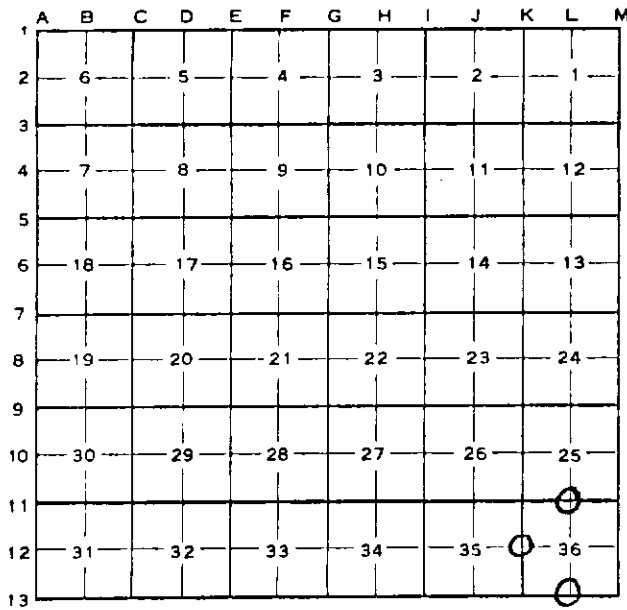

Apply letter prefix for corner points encircled above for identifying corner recordation numbers over.

FOR PROPERTY CONTROLLING AND MISC. PROPERTY CORNERS WITHIN THE SECTION (MENTIONED OVER AND EXCLUDE LOT CORNER)

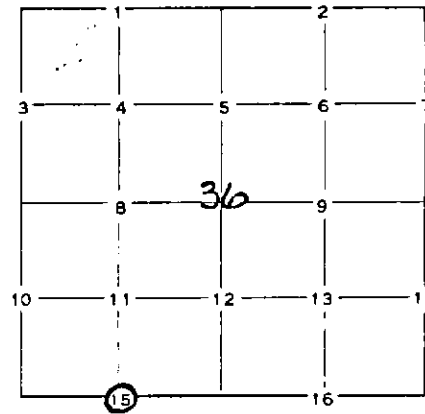

1. Above coded numbers are positioned on 1/16 fractional lines of the section.
2. Township corner code numbers shall be applied to corners of above typical section not numbered.
3. Miscellaneous property corners within a section, located at points other than numbered above, shall be referenced to at least two of above corner code numbers.
4. Private claim corners to be tied to rectangular land corners if possible - sketch required below.

EXPLANATORY SKETCH IF NECESSARY -- BELOW

