## LAND CORNER RECORDATION CERTIFICATE

**Filing Requirement of Act 74, Mich. P.A. 1970**

For corners in

**Wexford**
(County)

| | | Located In: | Corner Code ## |
|---|---|---|---|
| 1. Public Land Survey | | T 24N R 11W | C-7 |
| | | T 24N R 11W | C-8 |
| | | T 24N R 11W | C-9 |
| | | T R | |
| 2. Property Controlling | S | T R | |
| in Section | S | T R | |
| 3. Miscellaneous | S | T R | |
| Property in Sec | S | T R | |

**Register of Deeds Stamp & File Number**

4. Lot No. , Recorded Plat
5. Private Claims

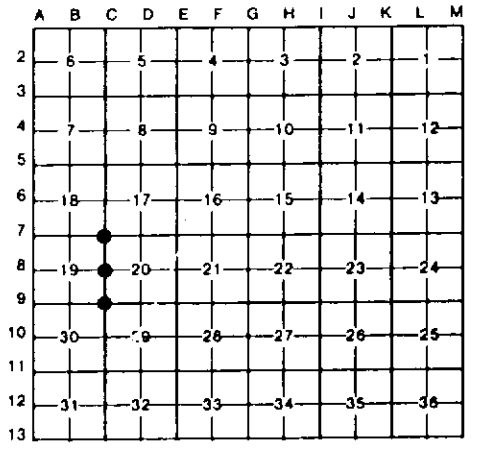


I, **Carl F. Roser**, in a field survey on **May 11**, 19 **87**, do hereby certify that under requirements of P.A. 74, Michigan P.A. of 1970, the corner points mentioned in lines 1 and 2 above were in conformance with regulations and rules therefore as required in the current manual of survey instructions of the United States Department of the Interior, Bureau of Land Management or by a decree of a Court of Law and/or that the corner points mentioned in lines 3, 4 and 5 above were in conformance with the rules of the Michigan Board of Land Surveyors or by a Decree of a Court of Law, established, re-established, monumented, re-monumented, recovered, found as expressed below:

**NOTE: Not more than 4 corners, all in the same town and range, may be recorded on this certificate.**

C. Continued:

C-9

| | | |
|---|---|---|
| Fd. 3/4" pipe | | |
| *37" Maple | N84°E | 88.0' |
| *28" Maple | N27°E | 31.1' |
| 12" Cherry | S14°E | 63.3' |
| Set cedar post w/loc tag | South | 33' |

*: Fargo witn (1913)

B. Description of corner evidence found and/or method applied in restoring or reestablishing corner:

C-7 - Re-established SW corner of Section 17 by double-proportion; one mile N-S-E & 1/2 mile west, (proportionate mea. to U.S.). Ctr. of winding N-S trail road is 158'± west.

C-8 - Re-established West 1/4 corner of Section 20 mid-way & on line between Section corners to North & South. The ctr. of an old (over-grown) N-S road grade is 80'± west.

C-9 - Found Fargo pipe (1913) for SW corner of Section 20.

C. Description of monument for corner and accessories established to perpetuate locating the position of the corner:

C-7

Set DNR monument & cedar post

| | | |
|---|---|---|
| 9" Twin Maple | N10°W | 46.0' |
| 9" White Pine | N80°E | 80.9' |
| 9" White Pine | S10°E | 55.8' |
| 9" Maple | S74°E | 61.6' |

C-8

Set DNR monument & cedar post

| | | |
|---|---|---|
| 4" Maple | S65°E | 2.3' |
| 12" Red Pine | S40°E | 45.4' |
| 5" Maple | S40°W | 26.7' |
| 14" Maple | N30°W | 30.1' |

Signed by Carl F. Roser 8-19-87 Date

Surveyor's Michigan License No. 12028

STATE OF MICHIGAN
CARL F. ROSER
LAND SURVEYOR
No. 12028
REGISTERED LAND SURVEYOR

FORM APPROVED BY MICHIGAN STATE BOARD OF LAND SURVEYORS NO. 8 1971
REVISED MAY, 1975
REVISED JAN., 1983