LAND CORNER RECORDATION CERTIFICATE
Filing Requirement of Act 74, Mich. P.A. 1970

For corners in
Wexford
(County)

		Located In:		Corner Code
1. Public Land Survey		T 24N	R 11W	D-5
		T 24N	R 11W	C-5
		T 24N	R 11W	C-6
		T	R	
2. Property Controlling	S 17	T 24N	R 11W	14
in Section	S	T	R	
3. Miscellaneous	S	T	R	
Property in Sec.	S	T	R	

Register of Deeds Stamp & File Number

4. Lot No. , Recorded Plat
5. Private Claims

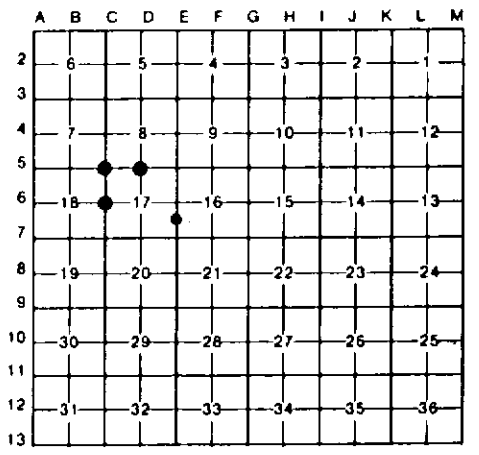

I, **Carl F. Roser**, in a field survey on **May 11**, 19 **87**, do hereby certify that under requirements of P.A. 74, Michigan P.A. of 1970, the corner points mentioned in lines 1 and 2 above were in conformance with regulations and rules therefore as required in the current manual of survey instructions of the United States Department of the Interior, Bureau of Land Management or by a decree of a Court of Law and/or that the corner points mentioned in lines 3, 4 and 5 above were in conformance with the rules of the Michigan Board of Land Surveyors or by a Decree of a Court of Law, established, re-established, monumented, re-monumented, recovered, found as expressed below.

NOTE: Not more than 4 corners, all in the same town and range, may be recorded on this certificate.

C. Continued:

C-5

Fd. round conc mon w/Brass cap
(G. Blass)
Fd. round conc
R.O.W. mon — North 32.95'
8" Maple — S60°W 53.24'
17" White Pine — S40°W 82.59'
11" Red Pine — S14°E 102.06'
Set ced post w/loc tag — S45°E 50'

C-6

Set DNR mon & cedar post
3" Cherry — N70°W 14.1'
8" Oak — N15°W 34.9'
3" Maple (clp) — S80°E 31.1'
12" Oak — S50°E 36.7'

B. Description of corner evidence found and/or method applied in restoring or reestablishing corner:

14 - Established NE corner of SE¼ of SE¼ of Section 17 per standard B.L.M. instructions.

D-5 - Fd. Blass monument for S¼ corner of Section 8. Fits U.S. tie west 561' to stream.

C-5 - Fd. Blass monument for NW corner Section 17. Ctr. of E-W gravel road is south 3'±. Ctr. of two-track north is 6'± East. Ctr. of two-track south is 3'± East

C-6 - Re-established west 1/4 corner of Section 17 equidistant & on line between Section corners to North & South. A N-S winding trail road is 150'± west.

C. Description of monument for corner and accessories established to perpetuate locating the position of the corner:

14

Drove 5/8" x 34" rerod w/RLS cap & set cedar post w/loc tag

10" White Pine — N56°E 31.5'
12" Red Pine — S20°E 15.7'
12" Red Pine — S56°W 11.8'
Ctr of Trail — West 71'

D-5

Fd round conc mon w/Brass cap, set cedar post w/loc tag (G. Blass)

7" Maple — N56°E 17.5'
8" White Pine — S40°E 16.1'
5" Maple — S58°W 27.1'
6" White Pine — N78°W 10.0'
Ctr old E-W rd grade — North 31'±

Signed by Carl F. Roser 8-19-87 Date

Surveyor's Michigan License No. 12028

STATE OF MICHIGAN
CARL F. ROSER
LAND SURVEYOR
12028
REGISTERED LAND SURVEYOR

FORM APPROVED BY MICHIGAN STATE BOARD OF LAND SURVEYORS JAN. 28, 1971
REVISED 1974