SURVEY & REMONUMENTATION

APR 2 5 1995

COMMISSION

RECEIVED

1994 DEC -9 PM 2:58

Linda Longmiller
WEXFORD COUNTY, MI
REGISTER OF DEEDS

LAND CORNER RECORDATION CERTIFICATE

Filing Requirement of Act 74, Mich. P.A. 1970

For corners in WEXFORD (County)

	Located In:	Corner Code ##
1. Public Land Survey	T 24N R 11W	F-13
	T ____ R ____	
	T ____ R ____	
	T ____ R ____	
2. Property Controlling	S ____ T ____ R ____	
in Section	S ____ T ____ R ____	
3. Miscellaneous	S ____ T ____ R ____	
Property in Sec.	S ____ T ____ R ____	

Register of Deeds Stamp & File Number

4. Lot No. _____ , Recorded Plat _____
5. Private Claims _____

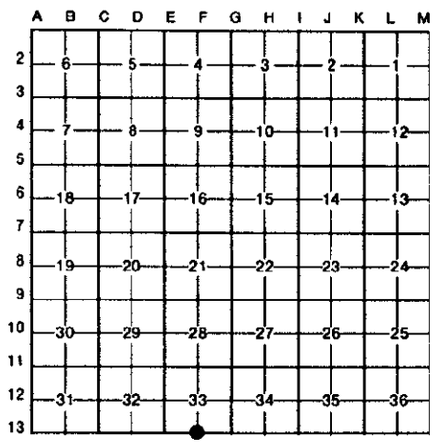

I, CRAIG J. PULLEN, in a field survey on AUGUST 17, 19 94, do hereby certify that under requirements of P.A. 74, Michigan P.A. of 1970, the corner points mentioned in lines 1 and 2 above were in conformance with regulations and rules therefore as required in the current manual of survey instructions of the United States Department of the Interior, Bureau of Land Management or by a decree of a Court of Law and/or that the corner points mentioned in lines 3, 4 and 5 above were in conformance with the rules of the Michigan Board of Land Surveyors or by a Decree of a Court of Law; established, re-established, monumented, re-monumented, recovered, found as expressed below:

NOTE: Not more than 4 corners, all in the same town and range, may be recorded on this certificate.

A. Description of original monument and accessories and/or subsequent restoration:

F-13
1838 GLO SURVEY BY J. BRINK, WOOD POST BEECH 11 N54½E 32 HEM 10 N29½W 34
1913 FARGO ENGINEERING SURVEY NO U.S. EVIDENCE CEDAR FENCE POST S35°W 0.49 CH NOTHING ELSE NEAR
1972 GOURDIE FRASER & ASSOC. SURVEY G. DELAMATER PS#13030 FIELD NOTES ONLY SET IRON & CAP MIDWAY AND ON LINE BETWEEN SW AND SE CORS. SEC. 33
1975 J.L. WILCOX & ASSOC. SURVEY J.L. WILCOX PS#14102 L.1 P.418 FOUND WEXFORD COUNTY MON. 3' E OF N-S FE., TREE LINE N, ON CENTERLINE OF CO. RD. NO.14 N25°W 10" CHERRY 42.18' S05°E 6" R. PINE 58.28' S60°E 5" R. PINE 67.83'
1989 J.L. WILCOX & ASSOC. SURVEY D. SCHRIPSEMA PS#24617 L.69 P.314 WEX. CO. MON. WITNESSES SAME AS 1975

B. Description of corner evidence found and/or method applied in restoring or reestablishing corner:

F-13 FOUND WEXFORD COUNTY MONUMENT IN FAIR CONDITION IN CENTERLINE ROAD AND ONE PREVIOUS WITNESS. DISTANCE FROM S¼ CORNER SECTION 33 TO SE CORNER SECTION 33 IS 2'± SHORT OF FARGO'S 1913 MEASUREMENT AND THE SAME AS G. DELAMATER'S 1972 DISTANCE. THIS CORNER IS ACCEPTED AS A CAREFUL AND FAITHFUL RE-ESTABLISHMENT OF THE POSITION OF THE ORIGINAL CORNER, BEING THE ¼ CORNER COMMON TO SECTION 33, T24N, R11W AND SECTION 4, T23N, R11W.

Peer Group Reviewed and Approved
Date: 12-9-94
Richard D. Wilcox
Richard D. Wilcox, Wexford County Surveyor

C. Description of monument for corner and accessories established to perpetuate locating the position of the corner:

F-13 S¼ CORNER SECTION 33, T24N, R11W
WEXFORD COUNTY MONUMENT

N27°W 16" CHERRY	42.20'
N53°W 12" POPLAR	38.97'
S3°W POWER POLE	36.81'
N54°E ½" IRON IN NORTH EDGE OF ROAD	26.36'

STATE OF MICHIGAN
CRAIG J. PULLEN
PROFESSIONAL SURVEYOR
No. 39095
LICENSED PROFESSIONAL SURVEYOR

LIBER 04 PAGE 306

Signed by Craig J. Pullen Date DECEMBER 7, 1994

Surveyor's Michigan License No. 39095

FORM APPROVED BY MICHIGAN STATE BOARD OF LAND SURVEYORS, JAN. 28, 1971
REVISED MAY 14, 1975
REVISED JAN., 1983