

SURVEY & REMONUMENTATION

APR 25 1995

COMMISSION

LAND CORNER RECORDATION CERTIFICATE
Filing Requirement of Act 74, Mich. P.A. 1970

RECEIVED

1994 DEC -9 PM 2: 58

For corners in WEXFORD

Linda Loughmiller
WEXFORD COUNTY, MI
REGISTER OF DEEDS

	(County)	Located In:		Corner Code #
		24N	11W	
1. Public Land Survey		T	R	L-13
		T	R	
		T	R	
		T	R	
2. Property Controlling in Section		S	R	
		S	R	
3. Miscellaneous Property in Sec.		S	R	
		S	R	

4. Lot No. _____, Recorded Plat _____

5. Private Claims _____

Register of Deeds Stamp & File Number

CRAIG J. PULLEN

NOVEMBER 8

94

I, _____, in a field survey on _____, 19 _____, do hereby certify that under requirements of P.A. 74, Michigan P.A. of 1970, the corner points mentioned in lines 1 and 2 above were in conformance with regulations and rules therefore as required in the current manual of survey instructions of the United States Department of the Interior, Bureau of Land Management or by a decree of a Court of Law and/or that the corner points mentioned in lines 3, 4 and 5 above were in conformance with the rules of the Michigan Board of Land Surveyors or by a Decree of a Court of Law; established, re-established, monumented, re-monumented, recovered, found as expressed below:

	A	B	C	D	E	F	G	H	I	J	K	L	M
2	6		5		4		3		2		1		
3													
4	7		8		9		10		11		12		
5													
6	18		17		16		15		14		13		
7													
8	19		20		21		22		23		24		
9													
10	30		29		28		27		26		25		
11													
12	31		32		33		34		35		36		
13													

NOTE: Not more than 4 corners, all in the same town and range, may be recorded on this certificate.

A. Description of original monument and accessories and/or subsequent restoration:

- L-13 1838 GLO SURVEY BY J. BRINK WOOD POST SUGAR 10 N54E 30 SUGAR 12 N37W 28
- 1972 J.L. WILCOX PS#14102 L.C.R.C. L.1 P.83 SET N¼ COR. SEC.1 T23N R11W PROP. DISTANCE & IN CENTERLINE EXISTING ROAD. SET IRON & CAP N10°W T. POLE 34.17' N80°E 24" MAPLE 119.52' S40°W 12" MAPLE 95.59' ROAD COMMISSION BOOK NOTES IRON & CAP BY WILCOX & ERICKSON.
- 1973 MDNR SURVEY C. ROSER PS#12028 L.C.R.C. L.2 P.622 FOUND WILCOX & ERICKSON IRON OF RECORD. ADDED STD. WEX. CO. MON. WITNESSES SAME AS WILCOX & ERICKSON. ADDED POST W/LOC. TAG N15W 35.4'


B. Description of corner evidence found and/or method applied in restoring or reestablishing corner:

- L-13 FOUND ½" IRON AND CAP #14102 IN CENTER OF BADLY DETERIORATED WEXFORD COUNTY MONUMENT IN CENTERLINE E-W ROAD AND 1 PREVIOUS WITNESS. THIS CORNER IS ACCEPTED AS A CAREFUL AND FAITHFUL RE-ESTABLISHMENT OF THE POSITION OF THE ORIGINAL CORNER, BEING THE ¼ CORNER COMMON TO SECTION 36, T24N, R11W AND SECTION 1, T23N, R11W. REMOVED ½" IRON AND CAP AND SET 5/8" X 36" IRON WITH BRASS CAP IN ITS PLACE IN REMAINS OF WEXFORD COUNTY MONUMENT.

Peer Group Reviewed and Approved
Date: 12-2-94
Richard D. Wilcox
Richard D. Wilcox, Wexford County Surveyor

C. Description of monument for corner and accessories established to perpetuate locating the position of the corner:

- L-13 S¼ CORNER SECTION 36, T24N, R11W
- 5/8" X 36" IRON WITH BRASS CAP STAMPED: CJP, 39095, 1994, ¼, 36, 1
- S40°W 24" MAPLE 95.59'
- S10°W FENCE POST 28.15'
- N56°E 10" RED PINE 86.74'
- S67°W 12" TWIN ELM 72.87'

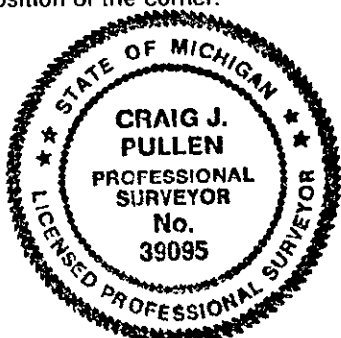

LIBER 04 PAGE 312

Signed by *Craig J. Pullen*
Surveyor's Michigan License No. 39095

Date NOVEMBER 30, 1994