

LAND CORNER RECORDATION CERTIFICATE

Filing Requirement of Act 74, Mich. PA 1970

For Corners In: Wexford Located In _____ Corner Code # _____
(County)

- | | | | | | |
|--------------------------------------|---|------------|---|------------|------------|
| 1. Public Land Survey | T | <u>24N</u> | R | <u>11W</u> | <u>C11</u> |
| | T | _____ | R | _____ | _____ |
| 2. Property Controlling in Section | S | _____ | T | _____ | _____ |
| | S | _____ | T | _____ | _____ |
| 3. Miscellaneous Property in Section | S | _____ | T | _____ | _____ |
| | S | _____ | T | _____ | _____ |

4. Lot No: _____ Recorded Plat: _____

5. Private Claims: _____

I, Craig W. McVean, in a field survey on June 4, 2003 do hereby state that under requirements of PA 74, Michigan PA of 1970, the corner points mentioned in lines 1 and 2 above were in conformance with regulations and rules therefore as required in the current manual of survey instructions of the United States Department of the Interior, Bureau of Land Management or by a decree of a Court of Law and/or that the corner points mentioned in lines 3, 4 and 5 above were in conformance with the rules of the Michigan Board of Land Surveyors or by a Decree of a Court of Law; established, re-established, monumented, recovered, found as expressed below:

NOTE: Not more than 2 corners, all in the same town and range, may be recorded on this certificate.

Register of Deeds Stamp & File Number

	A	B	C	D	E	F	G	H	I	J	K	L	M
1													
2	6		5		4		3		2		1		
3													
4	7		8		9		10		11		12		
5													
6	18		17		16		15		14		13		
7													
8	19		20		21		22		23		24		
9													
10	30		29		28		27		26		25		
11			●										
12	31		32		33		34		35		36		
13													

A. Description of original monument and accessories and/or subsequent restoration:


- | | |
|--|--|
| <p><u>C11</u> - GLO - Corner in river - J. Brink - 1838
 Elm 14" S40°E 71 L.
 Maple 10" S16°W 67 L.
 - Fargo Eng. - 1913 - No US Evidence
 Set iron pipe and crockery in edge river left bank.
 Cedar stp. 16" S21°E 34 Cedar Stp. 12" S12 1/2°W 27
 - LCRC - L. 3, p.190 - J. L. Wilcox - 1978
 Fd. 1" Fargo pipe - 1' below surface at high water line
 Set Wexford Co. Mon. 1' below surface.</p> | <p>N80°E 12" Cedar 27.09'; S55°E 12" Oak clump 42.88';
 S35°E 16" Cedar 54.95'; South 8" Oak stub 17.12';
 S21°E Cedar stp. 23.90'
 - "Manistee Meadows" - L. 7 of Plats, p. 348-350 -
 J. L. Wilcox - 1980
 - Rec. Sur. - L. 66, p.493 - J. L. Wilcox - 1988
 Same Wit. as LCRC</p> |
|--|--|

B. Description of corner evidence found and/or method applied in restoring or re-establishing corner:

C11 - Sec. Cor. Common to Sec. 29, 30, 31, and 32, T24N, R11W - Fd. 4" Wexford Co. Alum. Mon. w/ 3/4" Fargo pipe on W. side - down 1' - on S. Edge of Manistee River Bank - 1' S. of River. Fd. Remains of both of Fargo's BT's mostly gone that fit Mon. Found 3 witnesses by Wilcox and remains of 2 others; the distance to Cedar at N80°E being 10' longer than record. Fargo established position by double proportion to GLO. Wexford Co. Mon. accepted as a careful and faithful re-establishment of the position of the original corner.

C. Description of monument for corner and accessories established to perpetuate locating the position of the corner:

C11 - 4" Wexford Co. Alum. Mon. - Down 1'
 Set Blue Carsonite Post 1' NW
 N86°E 36.94' to set N & T in S. Side 17" Cedar (JLW)
 S50°E 42.89' to set N & T in SW side 13" Basswood Clp.-6 (JLW)
 S28°E 55.00' to set N & T in W side 20" Cedar (JLW)
 South 30.75' to set N & T in W side 6" Ash scribed 'XBT'
 S22°W 51.19' to set N & T in NW side 26" S. Maple scribed 'XBT'

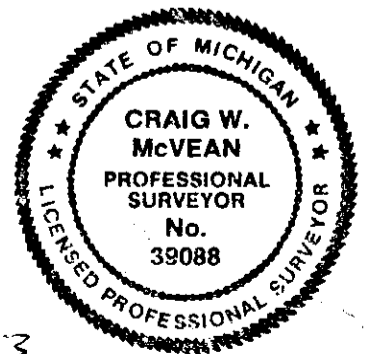

Signed by: Craig W. McVean
 Surveyor's Michigan License No.: 39088

Date: 11/10/2003