LAND CORNER RECORDATION CERTIFICATE

Filing Requirement of Act 74, Mich. PA 1970

For Corners In:
Wexford
(County)

		Located In			Corner Code #
1. Public Land Survey		T 24N	R 11W		D9
		T	R		
2. Property Controlling in Section	S	T	R		
	S	T	R		
3. Miscellaneous Property in Section	S	T	R		
	S	T	R		

Register of Deeds Stamp & File Number

4. Lot No: _____ Recorded Plat: _____

5. Private Claims: _____

I, Craig W. McVean, in a field survey on April 10, 2003 do hereby state that under requirements of PA 74, Michigan PA of 1970, the corner points mentioned in lines 1 and 2 above were in conformance with regulations and rules therefore as required in the current manual of survey instructions of the United States Department of the Interior, Bureau of Land Management or by a decree of a Court of Law and/or that the corner points mentioned in lines 3, 4 and 5 above were in conformance with the rules of the Michigan Board of Land Surveyors or by a Decree of a Court of Law; established, re-established, monumented, recovered, found as expressed below:

NOTE: Not more than 2 corners, all in the same town and range, may be recorded on this certificate.

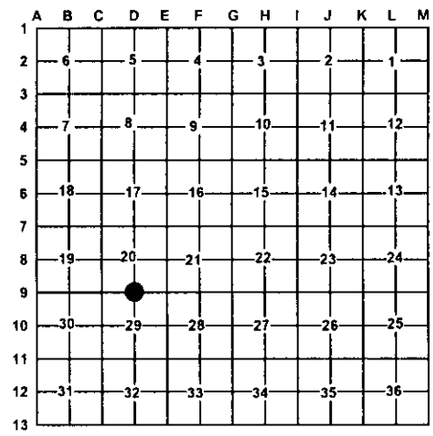

A. Description of original monument and accessories and/or subsequent restoration:

D9 – GLO – Set ¼ Post – J. Brink – 1839
Beech 10" N49°W 16 L.
Beech 8" S09°W 28 L.

- Fargo Eng. – 1913-No US evidence.
Set iron pipe w/ crockery, raised picket and red flag in center of traveled road.
WPS 30" N31°W 47 ½ L.
Sugar Maple 18" N69 ½° E 117 L.

B. Description of corner evidence found and/or method applied in restoring or re-establishing corner:

D9 – ¼ Corner common to Section 20 and 29 – Fd. ¾" x 2.5' long iron pipe w/ hooked end per Fargo Eng. in overgrown E-W two-track. Fit remains of Fargo's NW BT. Removed pipe and find remains of wood post, one butter dish and five broken pieces of another Butter dish alongside pipe. Fargo set pipe by single proportion. Fargo pipe accepted as a careful and faithful reestablishment of the position of the original corner.

C. Description of monument for corner and accessories established to perpetuate locating the position of the corner:

D9 – Replaced Fargo pipe with 4" DNR Aluminum cap on 1" x 36" Galvanized iron pipe with 1' of 4" PVC with concrete around cap. Placed five pieces of broken crockery at base of monument as memorial.

S13°E 12.71" to set N & T in E side 8" White Pine scribed 'XBT'
S50°W 15.73' to set N & T in SE side 8" White Pine scribed 'XBT'
N70°W 51.62' to set N & T in N side 7" White Pine scribed 'XBT'
N21°W 52.76' to set N & T in E side 14" Red Pine scribed 'XBT'
Set Blue Carsonite Post 1' N

STATE OF MICHIGAN
CRAIG W. McVEAN
PROFESSIONAL SURVEYOR
No. 39088
LICENSED PROFESSIONAL SURVEYOR

Signed by: Craig W. McVean Date: 11/10/2003

Surveyor's Michigan License No.: 39088

FORM APPROVED BY MICHIGAN STATE BOARD OF PROFESSIONAL SURVEYORS JAN. 28, 1971
Revised May 14, 1975
Revised Jan. 1983
Revised Oct. 1995