

LAND CORNER RECORDATION CERTIFICATE

Filing Requirement of Act 74, Mich. PA 1970

For Corners In: _____ Located In _____ Corner Code # _____
 Wexford _____
 (County) _____

1. Public Land Survey T 24N R 11W E12
 T _____ R _____
2. Property Controlling in Section S _____ T _____ R _____
 S _____ T _____ R _____
3. Miscellaneous Property in Section S _____ T _____ R _____
 S _____ T _____ R _____

4. Lot No: _____ Recorded Plat: _____
 5. Private Claims: _____

1. Craig W. McVean, in a field survey on May 22, 2003 do hereby state that under requirements of PA 74, Michigan PA of 1970, the corner points mentioned in lines 1 and 2 above were in conformance with regulations and rules therefore as required in the current manual of survey instructions of the United States Department of the Interior, Bureau of Land Management or by a decree of a Court of Law and/or that the corner points mentioned in lines 3, 4 and 5 above were in conformance with the rules of the Michigan Board of Land Surveyors or by a Decree of a Court of Law, established, re-established, monumented, recovered, found as expressed below.

NOTE: Not more than 2 corners, all in the same town and range, may be recorded on this certificate.


	A	B	C	D	E	F	G	H	I	J	K	L	M
1													
2	6	5	4	3	2	1							
3													
4	7	8	9	10	11	12							
5													
6	18	17	16	15	14	13							
7													
8	19	20	21	22	23	24							
9													
10	30	29	28	27	26	25							
11													
12	31	32	33	34	35	36							
13													

Register of Deeds Stamp & File Number

- A. Description of original monument and accessories and/or subsequent restoration:
- E12 - GLO - Set 1/4 Post - J. Brink - 1838
 Beech 10" N60°E 15 L.
 Beech 24" S82°W 32 L.
 - Fargo Eng. - 1913 - No US Evidence
 Set Iron pipe and crockery; WPS 40" S29°W 53 L.
 WPS 36" N76°W 64 3/4 L.
 - LCRC - L. 1, p. 306 and Rec. Sur. - L. 1, p.1-2 -
 L. M. Gerchbacher - 1973
 Found. 3/4" iron pipe; S29°W 34.98' - Pine Stp.;
 N76°W 42.74' Pine Stp.
- Rec. Sur. - L. 66, p.523 - J. L. Wilcox - 1987
 3/4" iron pipe - Same Wit. as Gerchbacher
 - Rec. Sur - L. 69, p.314 - D. E. Schripesema - 1989 -
 Same Wit. as Wilcox.

B. Description of corner evidence found and/or method applied in restoring or re-establishing corner:
 E12 - 1/4 Cor. Common Sec. 32 & 33, T24N, R11W - Fd. 4" Wexford Co. Alum. Mon. that fits Record Surveys in area. Fargo's witnesses are gone. Appears Wexford Mon. is replacement of Fargo pipe - probably by Wilcox & Assoc. but they couldn't provide documentation of this. Remains of N-S fence is 2' ± W. Pine Plantation to East. Wexford Co. Mon. accepted as the best available evidence of the position of the original corner.

C. Description of monument for corner and accessories established to perpetuate locating the position of the corner:
 E12 - 4" Wexford Co. Alum. Mon. Add stamping "1/4 S32/S33"
 Set Blue Carsonite Post 1' W
 N56°E 4.86' to set N & T in NW side 10" W. Pine
 S30°E 5.15' to set N & T in NE side 13" R. Pine
 S 64°W 112.88' to set N & T in N side 8" Cedar in Ctp.
 N63°W 105.28' to set N & T in SW side 8" Cedar in Ctp.

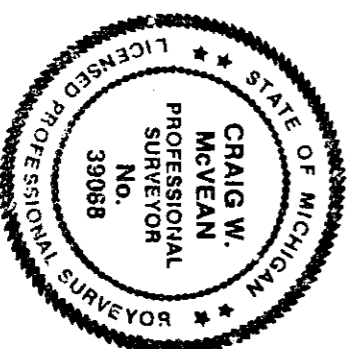

Signed by: Craig W. McVean
 Surveyor's Michigan License No.: 39088

Date: 11/19/2003