

# LAND CORNER RECORDATION CERTIFICATE

Filing Requirement of Act 74, Mich. PA 1970

For Corners In: Wexford Located In: \_\_\_\_\_ Corner Code # \_\_\_\_\_  
 (County)

1. Public Land Survey  
     T 24N R 11W F9  
     T \_\_\_\_\_ R \_\_\_\_\_
2. Property Controlling in Section  
     S \_\_\_\_\_ T \_\_\_\_\_ R \_\_\_\_\_  
     S \_\_\_\_\_ T \_\_\_\_\_ R \_\_\_\_\_
3. Miscellaneous Property in Section  
     S \_\_\_\_\_ T \_\_\_\_\_ R \_\_\_\_\_  
     S \_\_\_\_\_ T \_\_\_\_\_ R \_\_\_\_\_

4. Lot No: \_\_\_\_\_ Recorded Plat: \_\_\_\_\_  
 5. Private Claims: \_\_\_\_\_

1. Craig W. McVean, in a field survey on March 25, 2003 do hereby state that under requirements of PA 74, Michigan PA of 1970, the corner points mentioned in lines 1 and 2 above were in conformance with regulations and rules therefore as required in the current manual of survey instructions of the United States Department of the Interior, Bureau of Land Management or by a decree of a Court of Law and/or that the corner points mentioned in lines 3, 4 and 5 above were in conformance with the rules of the Michigan Board of Land Surveyors or by a Decree of a Court of Law, established, re-established, monumented, recovered, found as expressed below:

**NOTE: Not more than 2 corners, all in the same town and range, may be recorded on this certificate.**

	A	B	C	D	E	F	G	H	I	J	K	L	M
1													
2	6	5	4	3	2	1							
3													
4	7	8	9	10	11	12							
5													
6	18	17	16	15	14	13							
7													
8	19	20	21	22	23	24							
9													
10	30	29	28	27	26	25							
11													
12	31	32	33	34	35	36							
13													

Register of Deeds Stamp & File Number

**A. Description of original monument and accessories and/or subsequent restoration:**


- EG - GLO - Set 1/4 Post - J. Brink - 1839  
 Beech 13" S28°W 39 L.  
 Beech 14" N30°E 21 L.  
 - Fargo Eng. - 1913 - No US Evidence Found  
 Set Iron and crockery monument - B. Ash 16" N10° 45' E 12¾ L.  
 Elm 14" S25°W 8½ L.  
 - LCRC - L. 4, p. 60 and Rec. Sur. L. 69, p. 428 - J.A. Ray - 1990  
 Found 1" pipe (Fargo 1913). Set Wexford Co. monument  
 West 18" Cedar 36.65'; N36°W 12" Cedar 16.40'; N45°E 6" Cedar 17.20';  
 S5°W 4" Cedar 16.50'; N11°E 16" B. Ash 8.42' - Found Blaze

**B. Description of corner evidence found and/or method applied in restoring or re-establishing corner:**

- F9 - ¼ Corner Common to Sec. 21 & 28 - Found 4" Wexford Co. Alum. Cap. Monument with ¾" Fargo pipe on NE side per Ray.  
 Found remains of Fargo's B. Ash BT. Edge of Manistee River is 67' W. Fargo established position single proportion. Wexford Co. monument accepted as a careful and faithful re-establishment of the position of the original corner.

**C. Description of monument for corner and accessories established to perpetuate locating the position of the corner:**

- F9 - 4" Wexford Co. Alum. Cap. Monument - Add stamping "¼ S21/S28"  
 Set Blue Carsonite Post 1' N  
 West 36.56' to Fd. Nail in S. side 22" Cedar (JAR)  
 N36°W 16.44' to Fd. Nail in SW side 14" Cedar (JAR)  
 N38°E 17.15' to Fd. Nail in NW side 5" Cedar (JAR)  
 S2°W 16.43' to Fd. Nail in W side 5" Cedar (JAR)

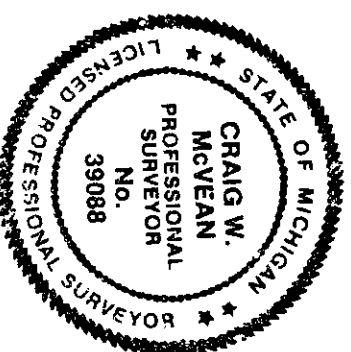

Signed by: Craig W. McVean  
 Surveyor's Michigan License No.: 39088

Date: 11/10/2003