


LAND CORNER RECORDATION CERTIFICATE

Filing Requirement of Act 74, Mich. PA 1970

For Corners In: <u>Wexford</u> (County)	Located In	Corner Code #	
1. Public Land Survey	T <u>24N</u> R <u>11W</u>	<u>G9</u>	
	T _____ R _____	_____	
2. Property Controlling in Section	S _____ T _____ R _____	_____	
	S _____ T _____ R _____	_____	
3. Miscellaneous Property in Section	S _____ T _____ R _____	_____	
	S _____ T _____ R _____	_____	
4. Lot No: _____	Recorded Plat: _____		
5. Private Claims: _____			

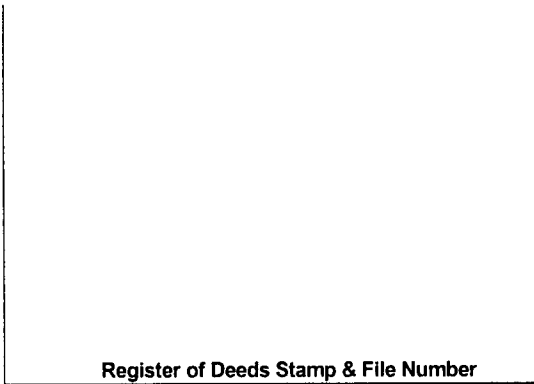

Register of Deeds Stamp & File Number

I, Craig W. McVean, in a field survey on June 3, 2003 do hereby state that under requirements of PA 74, Michigan PA of 1970, the corner points mentioned in lines 1 and 2 above were in conformance with regulations and rules therefore as required in the current manual of survey instructions of the United States Department of the Interior, Bureau of Land Management or by a decree of a Court of Law and/or that the corner points mentioned in lines 3, 4 and 5 above were in conformance with the rules of the Michigan Board of Land Surveyors or by a Decree of a Court of Law; established, re-established, monumented, recovered, found as expressed below:

NOTE: Not more than 2 corners, all in the same town and range, may be recorded on this certificate.

	A	B	C	D	E	F	G	H	I	J	K	L	M
1													
2	6		5		4		3		2		1		
3													
4	7		8		9		10		11		12		
5													
6	18		17		16		15		14		13		
7													
8	19		20		21		22		23		24		
9							●						
10	30		29		28		27		26		25		
11													
12	31		32		33		34		35		36		
13													

A. Description of original monument and accessories and/or subsequent restoration:

- | | |
|---|--|
| <p><u>G9</u> - GLO - Set Post - J. Brink - 1839
 Beech 8" N40°E 54 L.; Beech 8" S81°E 22 L.</p> <p>- Fargo Eng. - 1913 - No US Evidence
 Set iron post with crockery
 WPS 36" N67½°E 13¾ L.; WPS 32" S56½°E 33 L.</p> | <p>-LCRC - L. 4, p. 60 - J.A. Ray - 1990
 Found remains of old stake and crockery.
 Add Wexford Co. Monument, N48°E 6" R. Pine 53.75';
 N70°E 8" R. Pine 49.86'; S60°E 8" R. Pine 45.79'</p> |
|---|--|

B. Description of corner evidence found and/or method applied in restoring or re-establishing corner:

G9 - Sec. Cor. Common to Sec. 21, 22, 27 & 28 - Found 4" Wexford Co. Alum. Cap. monument per Ray. E. edge of Manistee River is 26' W. Remains of both of Fargo's W. Pine stps. in place and fits monument. Fargo established corner position by double proportion. Wexford Co. monument accepted as a careful and faithful re-establishment of the position of the original corner.

C. Description of monument for corner and accessories established to perpetuate locating the position of the corner:

- G9 - 4" Wexford Co. Alum. Cap Monument - added stamping "S21|S22"
 S28|S27
- Set Blue Carsonite Post 1'N
 N46°E 54.02' to set N & T in NW side 11" R. Pine (JAR)
 N68°E 50.13' to set N & T in N side 11" R. Pine (JAR)
 S60°E 46.06' to set N & T in SW side 11" R. Pine (JAR)
 S8°E 22.57' to set N & T in W side 44" R. Oak (JAR)



Signed by: Craig W. McVean
 Surveyor's Michigan License No.: 39088

Date: 11/10/2003