


LAND CORNER RECORDATION CERTIFICATE

Filing Requirement of Act 74, Mich. PA 1970

For Corners In: <u>Wexford</u> (County)	Located In	Corner Code #	
1. Public Land Survey	T <u>24N</u> R <u>11W</u>	<u>B9</u>	
	T _____ R _____	_____	
2. Property Controlling in Section	S _____ T _____ R _____	_____	
	S _____ T _____ R _____	_____	
3. Miscellaneous Property in Section	S _____ T _____ R _____	_____	
	S _____ T _____ R _____	_____	
4. Lot No: _____	Recorded Plat: _____		
5. Private Claims: _____			

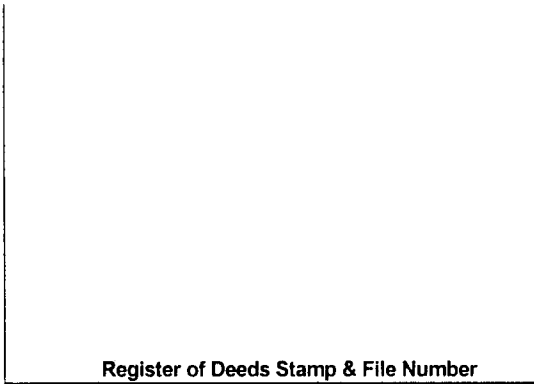

Register of Deeds Stamp & File Number

I, Craig W. McVean, in a field survey on April 22, 2003 do hereby state that under requirements of PA 74, Michigan PA of 1970, the corner points mentioned in lines 1 and 2 above were in conformance with regulations and rules therefore as required in the current manual of survey instructions of the United States Department of the Interior, Bureau of Land Management or by a decree of a Court of Law and/or that the corner points mentioned in lines 3, 4 and 5 above were in conformance with the rules of the Michigan Board of Land Surveyors or by a Decree of a Court of Law; established, re-established, monumented, recovered, found as expressed below:

NOTE: Not more than 2 corners, all in the same town and range, may be recorded on this certificate.

	A	B	C	D	E	F	G	H	I	J	K	L	M
1													
2	6		5		4		3		2		1		
3													
4	7		8		9		10		11		12		
5													
6	18		17		16		15		14		13		
7													
8	19		20		21		22		23		24		
9	●												
10	30		29		28		27		26		25		
11													
12	31		32		33		34		35		36		
13													

A. Description of original monument and accessories and/or subsequent restoration:

B9 - GLO - Set ¼ post, by J. Brink, 1839
 Beech 9" S80°W 15 L.
 Beech 10" N47°W 15 L.

-Mitchell and Associates – File # 20010616, Sept. 1, 2001-
 P. A. Trinklein. Found 1 ½" I.D. Iron Pipe
 South of Centerline trail 8'+
 S75°W 10" Maple 78.54'
 N08°W 16" Cherry 37.81'
 N40°W 14" Beech 56.27'
 N02°W 10" Beech 43.12'


- Fargo Eng. - 1913 - Found. 1 1/2" Iron pipe surrounded with crockery, scraps of iron, etc. buried there. Added good stake by it.
 Beech 20" N37 ½°W 53 L.
 Beech 18" S37 ½°W 106 ½ L.

B. Description of corner evidence found and/or method applied in restoring or re-establishing corner:

B9 – ¼ Corner Common to Sec. 19 & 30 -Found 1 ½" I.D. Iron pipe with pieces of glass and rotten scrap iron around. All GLO and Fargo Eng. witness trees gone. Fits Fargo distances East and West to A9, T24N, R11W and C9, T24N, R11W. Centerline of E-W two track is 8' north. 1 ½" I.D. Iron pipe is accepted as the best available evidence of the position of the original corner.

C. Description of monument for corner and accessories established to perpetuate locating the position of the corner:

B9 - Set 2" Aluminum Cap-properly stamped- on 5/8" x 34" rebar inside Fd. 1 ½" I.D. iron pipe.
 S76°W 78.57' to fnd. Nail in N. side 20" twin Sugar Maple (PAT)
 N63°W 43.12' to fnd. Nail in NE side 8" Beech, scribed 'XBT' (PAT)
 N37°W 56.30' to fnd. Nail in SW side 20" Beech, scribed 'XBT' (PAT)
 N09°W 37.79' to fnd. Nail in E side 11" triple Black Cherry (PAT)
 S49°E 45.17' to set Nail in SW side 6" triple Black Cherry
 Set Blue Carsonite Post 1' NE

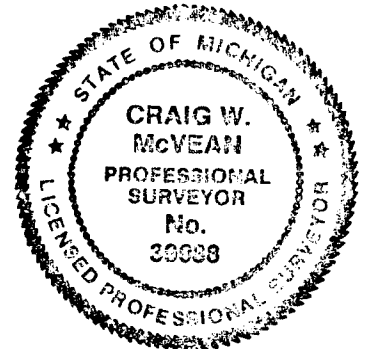

Signed by: Craig W. McVean
 Surveyor's Michigan License No.: 39088

Date: 11/10/2003