

# LAND CORNER RECORDATION CERTIFICATE


Filing Requirement of Act 74, Mich. PA 1970

For Corners In: Wexford (County)	Located In	Corner Code #	
1. Public Land Survey	T 24N R 11W	F13	
	T 23N R 11W	F1	
2. Property Controlling in Section	S _____ T _____ R _____	_____	_____
	S _____ T _____ R _____	_____	_____
3. Miscellaneous Property in Section	S _____ T _____ R _____	_____	_____
	S _____ T _____ R _____	_____	_____
4. Lot No: _____	Recorded Plat: _____		
5. Private Claims: _____			

Register of Deeds Stamp & File Number

I, Craig W. McVean, in a field survey on July 2, 2003 do hereby state that under requirements of PA 74, Michigan PA of 1970, the corner points mentioned in lines 1 and 2 above were in conformance with regulations and rules therefore as required in the current manual of survey instructions of the United States Department of the Interior, Bureau of Land Management or by a decree of a Court of Law and/or that the corner points mentioned in lines 3, 4 and 5 above were in conformance with the rules of the Michigan Board of Land Surveyors or by a Decree of a Court of Law; established, re-established, monumented, recovered, found as expressed below:

**NOTE: Not more than 2 corners, all in the same town and range, may be recorded on this certificate.**

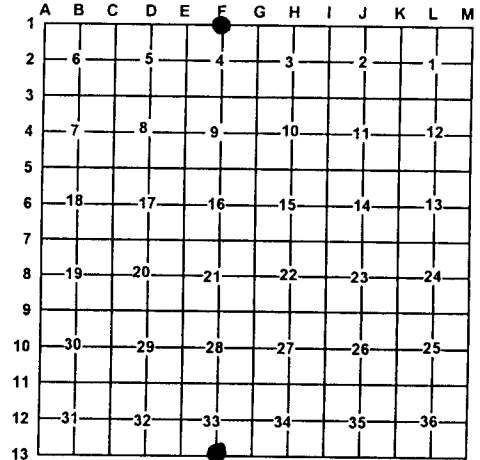

**A. Description of original monument and accessories and/or subsequent restoration:**


- |   |  |
|---|--|
| <p><u>F13 &amp; F1</u> - GLO - Set 1/4 Post - J. Brink - 1838<br/>                 Beech 11" N54 1/2°E 32 L.<br/>                 Hemlock 10" N29 1/2°W 34 L.<br/>                 - CSR - Pg. 93 - Alderman - 1899<br/>                 Fd. Corner placed by DeVoe. Distances<br/>                 E-39.85 CH., W-39.44 CH.<br/>                 - Fargo Eng. - 1913 - No US Evidence<br/>                 Set gas pipe and crockery. N-S Fence 2 L. W<br/>                 Cedar Fence post S35°W 43 L.</p> | <p>- Rec. Sur. - L. 1, p. 1 - L. M. Gershbacher - 1973<br/>                 Iron set midway between Sec. Corners E &amp; W.<br/>                 - Rec. Sur. - L. 1, p. 418 - J. L. Wilcox - 1975 - Fd. Wexford Co.<br/>                 Mon. - 3' E. of N-S. Fence, Treeline N. on CL. Co. Road.<br/>                 No. 14, N25°W 10" Cherry 42.18'; S5°E 6" R. Pine 58.28';<br/>                 S60°E 5" R. Pine 67.83'<br/>                 - Rec. Sur. - L. 69, p. 314 - D. E. Schripsema - Wexford Co. Mon.<br/>                 Same Wit. as Wilcox<br/>                 - Remon. LCRC - L. 4, p. 306 - C. J. Pullen - 1994<br/>                 Fd. Wexford Co. Mon. in fair condition; N27°W 16" Cherry 42.20';<br/>                 N53°W 12" Poplar 38.97'; S3°W PP 36.81'; N54°E -1/2" Iron N.<br/>                 Edge Rd. - 26.36'.</p> |
|---|--|

**B. Description of corner evidence found and/or method applied in restoring or re-establishing corner:**

F13 & F1 - Standard 1/4 Corner Common to Sec. 33, T24N, R11W and Sec. 4, T23N, R11W - Found 4" Wexford Co. Alum. Mon. in very poor condition in CL. E-W Gravel Road. Removed remains of Wexford Co. Mon. and upon further investigation find bent 3/4" x 2.5' long iron pipe per Fargo Eng. - N80° 55' W 0.80' from Wexford Mon. position. Base of Fargo pipe surrounded by broken butter dishes. Old fence line remains S. is 2' ± West. Fargo set pipe by single proportion. Measure grid distance E- 2608.50' vs. 2610.3' Fargo and W-2607.33' vs. 2610.3' Fargo. Accepted Fargo pipe as a careful and faithful re-establishment of the position of the original corner.

**C. Description of monument for corner and accessories established to perpetuate locating the position of the corner:**

F13 & F1 - Replaced 3/4" Fargo pipe w/ 1 1/2" Wexford Co. Brass Cap. on 5/8" x 34" rebar w/ 4" x 1' long PVC w/ conc. around cap down 0.7'. Cap stamped "1/4 33/4 39088". Placed broken butter dishes at base mon. as memorial.  
 S3°W 36.91' to Fd. Nail in E. side PP (CJP)  
 N53°W 38.23' to Fd. Nail in SW side 14" Poplar (CJP)  
 N27°W 41.68' to Fd. Nail in W side 14" Cherry (CJP)  
 N54°E 26.92' to Fd. 1/2" iron (CJP)  
 S80° 55'E 0.80' - Removed Wexford Co. Alum. Mon. position.

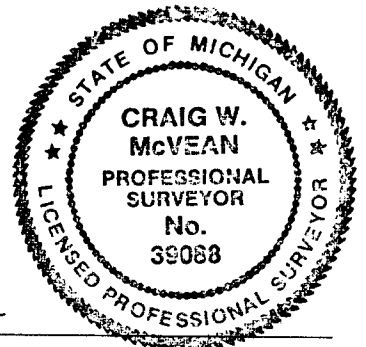

Signed by: Craig W. McVean  
 Surveyor's Michigan License No.: 39088

Date: 8/30/2004