

# LAND CORNER RECORDATION CERTIFICATE

## Filing Requirement of Act 74, Mich. PA 1970

For Corners In: \_\_\_\_\_ Located In \_\_\_\_\_ Corner Code # \_\_\_\_\_  
 Wexford \_\_\_\_\_  
 (County) \_\_\_\_\_

1. Public Land Survey	T _____	R _____	_____	_____
	T _____	R _____	_____	_____
2. Property Controlling in Section	S 33 T 24N	R 11W	6	_____
	S 33 T 24N	R 11W	7	_____
3. Miscellaneous Property in Section	S _____	T _____	R _____	_____
	S _____	T _____	R _____	_____

4. Lot No: \_\_\_\_\_ Recorded Plat: \_\_\_\_\_  
 5. Private Claims: \_\_\_\_\_

1. Craig W. McVean, in a field survey on July, 30, 2003 do hereby state that under requirements of PA 74, Michigan PA of 1970, the corner points mentioned in lines 1 and 2 above were in conformance with regulations and rules therefore as required in the current manual of survey instructions of the United States Department of the Interior, Bureau of Land Management or by a decree of a Court of Law and/or that the corner points mentioned in lines 3, 4 and 5 above were in conformance with the rules of the Michigan Board of Land Surveyors or by a Decree of a Court of Law, established, re-established, monumented, recovered, found as expressed below:


**NOTE: Not more than 2 corners, all in the same town and range, may be recorded on this certificate.**

	A	B	C	D	E	F	G	H	I	J	K	L	M
1													
2	6	5	4	3	2	1							
3													
4	7	8	9	10	11	12							
5													
6	18	17	16	15	14	13							
7													
8	19	20	21	22	23	24							
9													
10	30	29	28	27	26	25							
11													
12	31	32	33	34	35	36							
13													

Register of Deeds Stamp & File Number

A. Description of original monument and accessories and/or subsequent restoration:

6 - None Z - None

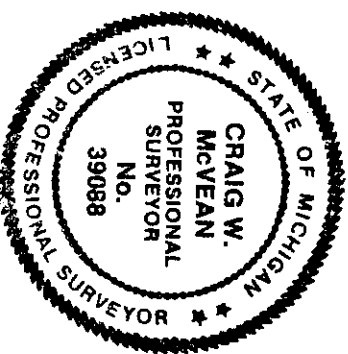

B. Description of corner evidence found and/or method applied in restoring or re-establishing corner:

6 - NE 1/16 Cor. Section 33 - Set 2" Alum. Cap on Z - N 1/16 corner common to section 33 & 34 -  
 5/8" x 34" Rebar per Standard BLM procedure. Also fd. Set 2" Alum. Cap on 5/8" x 34" rebar per standard  
 1/2" capped iron #12016' - N65°56'E 4.14' - which we BLM procedure. CL. of N-S Gravel Rd. is 16' W.  
 rejected as Cor. '6'.

C. Description of monument for corner and accessories established to perpetuate locating the position of the corner:

6 - NE 1/16 corner section 33 Z - N 1/16 corner common to section 33 & 34  
 2" aluminum cap stamped on a 5/8" X 34" rebar. 2" aluminum cap stamped on a 5/8" X 34" rebar  
 S10°E 25.03' to set nail & tag in W side of 12" R. Pine N22°E 19.07" to set nail & tag in W side of 14" Cedar  
 S52°W 19.72' to set nail & tag in NW side of 6" R. Pine N75°E 33.91' to set nail & tag in S side of 8" Cedar  
 N70°W 25.47' to set nail & tag in NE side of 10" R. Pine S28°E 24.70' to set nail & tag in W side of 8" Cedar  
 N60°E 2.25' to set nail & tag in SE side of 5" R. Pine Set blue carsonite post with location tag 1' North  
 Set blue carsonite post with location tag 1' NW N87°39'W 32.26' to Fd. 1/2" CIR #12016 - 0.85' North of line  
 N65°56' E 4.14' to Fd. 1/2" CIR #12016

Signed by: Craig W. McVean  
 Surveyor's Michigan License No.: 39088

Date: 1/10/2003