

LAND CORNER RECORDATION CERTIFICATE

FILING REQUIREMENT OF ACT 74, MICH. P.A.1970

FOR CORNERS OF--	LOCATED IN--	CORNER CODE NUMBER
1. PUBLIC LAND SURVEY	T. 24 N. R. 12 ● ● W.	C-7; D-5
2. PROPERTY CONTROLLING IN SECTION	T. S. R. E. W.	
3. MISCELLANEOUS PROPERTY IN SECTION 20	T. 24 N. R. 12 ● ● W. Sec. 20 code 1 & 1000.84' E of C-7)	ZZZ (333.61' W of
4. LOT NO. _____, RECORDED PLAT _____		
5. PRIVATE CLAIMS _____		

REGISTER OF DEEDS STAMP AND
FILING NUMBER

I, Carl F. Roser, do hereby certify that under requirements of P.A. 74, Michigan P.A. of 1970, the corner points mentioned in lines 1 and 2 above were, in a field survey on May 25, 1976, established, re-established, monumented, re-monumented, recovered or restored as expressed below and in conformance with regulations and rules therefore as required in the current manual of survey instructions of the United States Department of the Interior, Bureau of Land Management or by a decree of a court of law. Furthermore, that the corner points mentioned in lines 3, 4 and 5 above were, in a field survey on June 28, 1976, found, recovered, restored, established or re-established as expressed below and in conformance with the rules of the Michigan State Board of Registration for Land Surveyors or, by a Decree of a Court of law:

A. Description of original monument and accessories and/or subsequent restoration:

B. Description of corner evidence found and/or method applied in restoring or re-establishing corner:

- C-7 Found very old 5/8" rod & old plow point & piece of iron & added Wexford Co. mon. Corner fits Walter Johnson survey of Sec. 20 in 1916.
- D-5 Found & accepted 2" pipe which is a result of survey by RLS Frank McClung (deceased) in 1961. Corner fits reasonably well for straight line and half-way between section corners one-half mile to east and west.
- ZZZ Established the NW corner of E $\frac{1}{4}$ of NW $\frac{1}{4}$ of NW $\frac{1}{4}$ of Sec. 20, on N line of Sec. 20, S89°32'10"W, 333.61' from W 1/16 on N line Section 20.

C. Description of monument for corner and accessories established to perpetuate locating the position of the corner:

	C-7	D-5		ZZZ
Set std. Wexford Co. Monument		Fd. 2" pipe & old post & added cedar post w/loc. tag		Drove 1 $\frac{1}{4}$ "x21" rod (buried in road)
14" B.Cherry	S14°W 80.8	6" B.Cherry S64°E 16.6		Power Pole N46°E 46.32
14" Maple	N61°W 63.2	5" Ironwood S13°W 16.9		30" B.Cherry S51°E 94.70
20" B.Cherry	N19°W 90.6	7" Maple S72°W 6.5		Set cedar post w/loc. tag
Set cedar post w/loc. tag		9" Maple N33°W 27.0		Due S 33'
Due S 33'				Fence to S Due W 20'

SIGNED BY Carl F. Roser 4-28-77 DATE _____


SURVEYOR'S MICHIGAN REGISTRATION NO. 12028

FOR STATE AND UNITED STATES AGENCIES:

SIGNED BY _____ DATE _____

APPROVED AND SIGNED BY _____ DATE _____

MICHIGAN REGISTERED LAND SURVEYOR

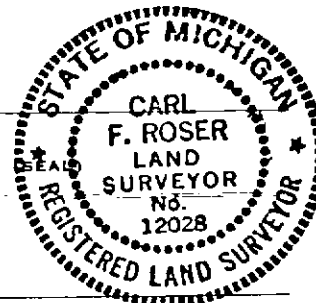

WEXFORD TOWNSHIP
WEXFORD COUNTY

SURVEYOR'S MICHIGAN REGISTRATION NO. _____