

LAND CORNER RECORDATION CERTIFICATE

FILING REQUIREMENT OF ACT 74, MICH. P.A.1970

FOR CORNERS OF—:	LOCATED IN—:	CORNER CODE NUMBER
1. PUBLIC LAND SURVEY _____	T. 24 N. R. 12 ● W.	D-4; E-4
2. PROPERTY CONTROLLING IN SECTION 8 _____	T. 24 N. R. 12 ● W.	8; 15
3. MISCELLANEOUS PROPERTY IN SECTION _____	T. _____ N. S. R. _____ E. W.	
4. LOT NO. _____, RECORDED PLAT _____		
5. PRIVATE CLAIMS _____		

REGISTER OF DEEDS STAMP AND FILING NUMBER

I, Carl F. Roser, do hereby certify that under requirements of P.A. 74, Michigan P.A. of 1970, the corner points mentioned in lines 1 and 2 above were, in a field survey on June 21, 1976, established, re-established, monumented, re-monumented, recovered or restored as expressed below and in conformance with regulations and rules therefore as required in the current manual of survey instructions of the United States Department of the Interior, Bureau of Land Management or by a decree of a court of law. Furthermore, that the corner points mentioned in lines 3, 4 and 5 above were, in a field survey on _____, 19____, found, recovered, restored, established or re-established as expressed below and in conformance with the rules of the Michigan State Board of Registration for Land Surveyors or, by a Decree of a Court of law:

A. Description of original monument and accessories and of subsequent substitution
 C. (CONTINUED)

- 15
- Set 1"x36" pipe-cedar post w/loc. tag
 - 12" Maple Due S 9.1
 - 7" Maple S53°W 20.0
 - 14" Maple N53°W 11.7
 - 10" Maple N47°E 22.8

B. Description of corner evidence found and/or method applied in restoring or re-establishing corner:

- D-4 Set center of Section 8 at intersection of ¼ lines.
- E-4 Accepted 3/4" rerod as estab. by Fluharty RLS #18223, equidistant & on line between section corners to N & S. Old fences are highly irreg. in this area & stream crossing does not make sense with Govt. survey.
- 8 Established 1/16 corner per standard B.L.M. instructions.
- 15 Established 1/16 corner per standard B.L.M. instructions.

C. Description of monument for corner and accessories established to perpetuate locating the position of the corner:

D-4	E-4	8
Set 1½"x28" pipe & cedar post w/loc. tag	Fd. 3/4" rod-set cedar post w/loc. tag	1½"x30" pipe-cedar post w/loc. tag
12" B.Cherry N81°E 109.2	12" Cedar N72°E 13.32	8" Maple S29°E 21.8
10" B.Cherry N02°E 81.6	6" Cedar N45°E 20.47	9" Maple S38°W 29.7
10" Maple S87°W 81.7	8" Cedar N06°E 25.57	7" Ironwood N63°W 26.9
12" B.Cherry S19°E 145.2	16" Cedar N80°W 15.80	7" Maple N37°E 12.7
Old N-S Fence Due E 37'		
Old Fence to E Due S 42'		


SIGNED BY Carl F. Roser 4-28-77 DATE _____

SURVEYOR'S MICHIGAN REGISTRATION NO. 12028

FOR STATE AND UNITED STATES AGENCIES:

SIGNED BY _____ DATE _____
CHIEF OF SURVEY PARTY

APPROVED AND SIGNED BY _____ DATE _____
MICHIGAN REGISTERED LAND SURVEYOR

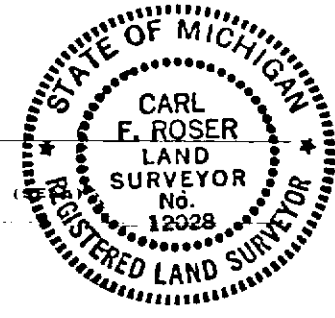

SURVEYOR'S MICHIGAN REGISTRATION NO. _____ WEXFORD TOWNSHIP
 WEXFORD COUNTY