

LAND CORNER RECORDATION CERTIFICATE

FILING REQUIREMENT OF ACT 74, MICH. P.A.1970

FOR CORNERS OF--	LOCATED IN--	CORNER CODE NUMBER
1. PUBLIC LAND SURVEY _____	T. 24 N. R. 12 W. ●	E-5; E-6; F-5
2. PROPERTY CONTROLLING IN SECTION 16 _____	T. 24 N. R. 12 W. ●	1
3. MISCELLANEOUS PROPERTY IN SECTION _____	T. _____ N. S. R. _____ E. W.	
4. LOT NO. _____, RECORDED PLAT _____		
5. PRIVATE CLAIMS _____		

REGISTER OF DEEDS STAMP AND FILING NUMBER

I, Carl F. Roser, do hereby certify that under requirements of P.A. 74, Michigan P.A. of 1970, the corner points mentioned in lines 1 and 2 above were, in a field survey on June 16, 1976, established, re-established, monumented, re-monumented, recovered or restored as expressed below and in conformance with regulations and rules therefore as required in the current manual of survey instructions of the United States Department of the Interior, Bureau of Land Management or by a decree of a court of law. Furthermore, that the corner points mentioned in lines 3, 4 and 5 above were, in a field survey on _____, 19____, found, recovered, restored, established or re-established as expressed below and in conformance with the rules of the Michigan State Board of Registration for Land Surveyors or, by a Decree of a Court of law:

~~A = Description of original monument or accessories established by a decree of a court of law~~
 C. (CONTINUED)

- 1
- Set 1"x48" pipe-cedar post w/loc. tag
 - 6" Cedar N26°E 81.6
 - 14" Cedar S36°E 47.3
 - 8" Cedar (partially dead)
 - S62°W 31.8
 - Center E-W dirt rd. Due N 10'±
 - Old fence to N Due W 2.5'

B. Description of corner evidence found and/or method applied in restoring or re-establishing corner:

- E-5 Found new 3/4" pipe by RLS #18223. Pipe is a result of Fluherty's work in Sec. 9.
- E-6 Restored 1/4 corner in approximate center of old E-W twp. road grade & 33' E of row of old large maples w/wire in them to S and in line with old field edge berm to S. Corner restored by this method is approx. 13' N & 21' W of comp. 1/4 corner position by proportion between section corners to N & S.
- F-5 Fd. pipe w/RLS cap #18223 in approx. center of E-W dirt road & in line with old fence to N. Fence to S is due W 3'.
- 1 Established 1/16 corner per standard B.L.M. instructions.

C. Description of monument for corner and accessories established to perpetuate locating the position of the corner:

E-5	E-6	F-5
Fd. pipe-replaced w/Wexford Co. Mon. & ced.post w/loc. tag	Set std. Wexford Co. Mon. (buried) in old road grade	Fd. pipe & added Wexford Co. Monument (buried)
9" Tri-Maple S65°E 9.79	19" Maple S72°W 41.5	36" Maple N06°E 46.66
8" Maple S23°W 20.48	6" Maple N43°W 40.9	5" S.Pine N36°E 64.52
9" Maple S54°W 39.43	8" Maple N06°E 50.9	4" Twn.R.Pine S68°W 100.92
10" Quad-Maple S77°W 6.74	12" Maple N56°E 64.2	Set cedar post w/loc. tag
Old E-W Fence Due N 9'±	Set cedar post w/loc. tag Due N 33'	Due S 33'

SIGNED BY Carl F. Roser 4-28-77 DATE _____

SURVEYOR'S MICHIGAN REGISTRATION NO. 12028


FOR STATE AND UNITED STATES AGENCIES:

SIGNED BY _____ DATE _____

CHIEF OF SURVEY PARTY

APPROVED AND SIGNED BY _____ DATE _____

MICHIGAN REGISTERED LAND SURVEYOR

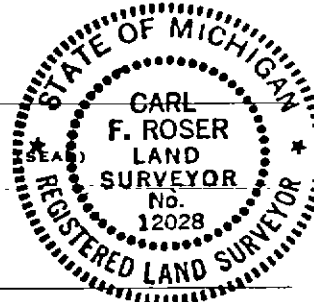

(SEAL)

WEXFORD TOWNSHIP
WEXFORD COUNTY

SURVEYOR'S MICHIGAN REGISTRATION NO. _____