

SURVEY & REMONUMENTATION

FEB 11 1998

LAND CORNER RECORDATION CERTIFICATE
Filing Requirement of Act 74, Mich. P.A. 1970

SECTION
For corners in

WEXFORD Located In: _____ Corner Code # _____
(County)

1. Public Land Survey T 24N R 12W _____ C-13
T _____ R _____
T _____ R _____
T _____ R _____

2. Property Controlling S _____ T _____ R _____
in Section S _____ T _____ R _____

3. Miscellaneous S _____ T _____ R _____
Property in Sec. S _____ T _____ R _____

4. Lot No. _____, Recorded Plat _____

5. Private Claims _____

RECEIVED

1997 DEC 11 AM 9:29

Linda Loughmiller
WEXFORD COUNTY, MI
REGISTER OF DEEDS

Register of Deeds Stamp & File Number

1	A	B	C	D	E	F	G	H	I	J	K	L
2		6		5		4		3		2		1
3												
4		7		8		9		10		11		1
5												
6		18		17		16		15		14		1
7												
8		19		20		21		22		23		2
9												
10		30		29		28		27		26		2
11												
12		31		32		33		34		35		3
13												

I, CRAIG J. PULLEN, in a field survey on MARCH 24, 1997, do hereby state that under requirements of P.A. 74, Michigan P.A. of 1970, the corner points mentioned in lines 1 and 2 above were in conformance with regulations and rules therefore as required in the current manual of survey instructions of the United States Department of the Interior, Bureau of Land Management or by a decree of a Court of Law and/or that the corner points mentioned in lines 3, 4 and 5 above were in conformance with the rules of the Michigan Board of Land Surveyors or by a Decree of a Court of Law; established, re-established, monumented, recovered, found as expressed below:


NOTE: Not more than 2 corners, all in the same town and range, may be recorded on this certificate.

A. Description of original monument and accessories and/or subsequent restoration:
C-13 1838 G.L.O. SURVEY BY J. BRINK, WOOD POST SUGAR 10 N69E 59 BEECH 8 N62W 27 CLOSING WITNESSES BEECH 10 S20E 31 SUGAR 13 S40W 31
1902 E.E. SOURS COUNTY SURVEYOR RECORDS FOUND IRON POST SET TO PRESERVE CORNER BY RESIDENTS
1916 E.E. SOURS COUNTY SURVEYOR RECORDS P. 238 NO CORNER DESCRIPTION GIVEN MAPLE 6" SW 35.7' MAPLE 9" NE 30.2' DISTANCE TO SOUTH 1/4 CORNER SECTION 31, 2618.5'; DISTANCE TO SOUTH 1/4 CORNER SECTION 32, 262
1990 WADE-TRIM/GRANGER SURVEY BY J. RAY, PS #25869 IN SECTION 5, T23N, R12W FOUND 1" BAR IN LINE 0.5' SOUTH OF THE CENTERLINE OF 14 ROAD, N16"E 24" MAPLE 43.77' N60"E 20" MAPLE 77.00' S18"W 8" MAPLE 45.75'
1992 GRAND TRAVERSE SURVEYING CO. SURVEY BY N. WAY, PS #28432 IN SECTION 6, T23N, R12W FOUND 1 1/2" BAR 18" BELOW SURFACE, RAISED WITH 1/2" IRON & CAP #31611, N11"E 24" MAPLE 43.74' N55"E 20" MAPLE 76.93' S35"W 12" MAPLE 60.65' S82"W 12" MAPLE 81.40'

B. Description of corner evidence found and/or method applied in restoring or reestablishing corner:
C-13 FOUND 1/2" IRON & CAP IN CENTERLINE OF 14 ROAD AND 4 PREVIOUS WITNESSES. REPLACED 1/2" IRON WITH 5/8" X 36" IRON & BRASS CAP. THIS CORNER IS ACCEPTED AS THE BEST AVAILABLE EVIDENCE OF THE POSITION OF THE CORNER.

C. Description of monument for corner and accessories established to perpetuate locating the position of the corner:
C-13 SECTION CORNER COMMON TO SECTIONS 31 & 32, T24N, R12W, AND SECTIONS 5 & 6, T23N, R12W
5/8" X 36" IRON WITH BRASS CAP STAMPED: CJP, 39095, 1997, 31, 32, 5, 6
N11"E 24" MAPLE 43.74'
N55"E 18" MAPLE 77.00'
S35"W 12" MAPLE 60.65'
S82"W 12" MAPLE 81.38'

Peer Group Reviewed and Approved
Date: 30 Oct 97
Richard D. Wiley
Richard D. Wiley, Wexford County Surveyor

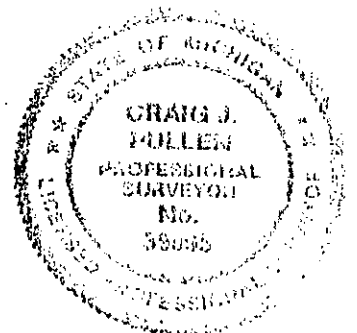

Signed by Craig J. Pullen
Surveyor's Michigan License No. 39095

Date December 2, 1997