

SURVEY & REMONUMENTATION

FEB 11 1998

LAND CORNER RECORDATION CERTIFICATE Filing Requirement of Act 74, Mich. P.A. 1970

SECTION

For corners in

<u>WEXFORD</u> (County)	Located In:	Corner Code #
1. Public Land Survey	T <u>24N</u> R <u>12W</u>	<u>D-13</u>
	T _____ R _____	_____
	T _____ R _____	_____
	T _____ R _____	_____
2. Property Controlling in Section	S _____ T _____ R _____	_____
	S _____ T _____ R _____	_____
3. Miscellaneous Property in Sec.	S _____ T _____ R _____	_____
	S _____ T _____ R _____	_____
4. Lot No. _____, Recorded Plat _____		
5. Private Claims _____		

RECEIVED
1997 DEC 11 AM 9:29
Linda Longmiller
WEXFORD COUNTY, MI
REGISTER OF DEEDS

Register of Deeds Stamp & File Num

1	A	B	C	D	E	F	G	H	I	J	K	L
2		6		5		4		3		2		1
3												
4		7		8		9		10		11		1
5												
6		18		17		16		15		14		
7												
8		19		20		21		22		23		
9												
10		30		29		28		27		26		2
11												
12		31		32		33		34		35		3
13												

I, CRAIG J. PULLEN, in a field survey on MARCH 24, 1997, do hereby state that under requirements of P.A. 74, Michigan P.A. of 1970, the corner points mentioned in lines 1 and 2 above were in conformance with regulations and rules therefore as required in the current manual of survey instructions of the United States Department of the Interior, Bureau of Land Management or by a decree of a Court of Law and/or that the corner points mentioned in lines 3, 4 and 5 above were in conformance with the rules of the Michigan Board of Land Surveyors or by a Decree of a Court of Law: established, re-established, monumented, recovered, found as expressed below:


NOTE: Not more than 2 corners, all in the same town and range, may be recorded on this certificate.

A. Description of original monument and accessories and/or subsequent restoration:
D-13 1838 G.L.O. SURVEY BY J. BRINK, WOOD POST SUGAR 11 N15E 61 BEECH 8 N62W 27
1916 E.E. SOURS COUNTY SURVEYOR NOTES FOR SECTION 31 & 32, T24N, R12W NO CORNER DESCRIPTION OR WITNESSES GIVEN, DISTANCE FROM SW CORNER OF SECTION 32 TO SOUTH 1/4 OF SECTION 32, 2628'
1937 MICHIGAN DEPARTMENT OF TRANSPORTATION RIGHT-OF-WAY SHEET FOR M-115 CORNER SHOWN IN CENTERLINE OF 14 ROAD AND 73.7' SOUTH OF TANGENT OF M-115 CENTERLINE AND IN LINE WITH NORTH AND SOUTH FENCES
1990 WADE-TRIM/GRANGER SURVEY IN SEC. 5, T23N, R12W, BY J. RAY PS #25869 SET 1/2" IRON & CAP HALF WAY BETWEEN NW COR AND NE COR SECTION 5 (2624.05' BOTH WAYS) AND IN CENTERLINE OF 14 ROAD 1/8 LINE FENCE 1313' EAST S50"E 12" MAPLE 73.56' S8"E 8" MAPLE 49.54' NORTH CENTERLINE OF M-115 70' (78' TO TANGENT) EAST CENTERLINE OF M-115 206'
1993 J. ERICKSON PS #16929 SURVEY IN SECTION 5, T23N, R12W L. 72, P. 360 NO CORNER DESCRIPTION OR WITNESSES GIVEN, DISTANCE TO SOUTH 1/4 OF SECTION 5307.83' (5308.71' WADE-TRIM 1990)

B. Description of corner evidence found and/or method applied in restoring or reestablishing corner:
D-13 FOUND 1/2" IRON AND CAP IN CENTERLINE OF 14 ROAD AND 4 PREVIOUS WITNESSES. REPLACED 1/2" IRON WITH 5/8" X 36" IRON AND BRASS CAP. THIS CORNER IS ACCEPTED AS A CAREFUL AND FAITHFUL REESTABLISHMENT OF THE POSITION OF THE ORIGINAL CORNER.

C. Description of monument for corner and accessories established to perpetuate locating the position of the corner:
D-13 1/4 CORNER COMMON TO SECTION 32 T24N, R12W, AND SECTION 5, T23N, R12W
5/8" X 36" IRON & BRASS CAP STAMPED: CJP, 39095, 1997, 32, 5, 1/4
S50"E 14" MAPLE 73.56'
S8"E 8" MAPLE 49.54'
S54"W 6" POPLAR 56.74'
NORTH TANGENT OF M-115 78.00'. (70.00 TO CENTERLINE)
EAST CENTERLINE OF M-115 206.00'

Peer Group Reviewed and Approved
Date: 30 Oct 97
Richard D. Wilcox
Richard D. Wilcox, Wexford County Surveyor

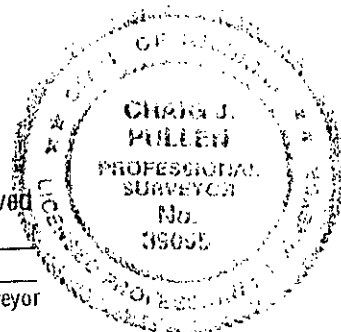

Signed by *Craig J. Pullen*
Surveyor's Michigan License No. 39095

Date December 2, 1997