

SURVEY & REMONUMENTATION

FEB 1 1 1998

LAND CORNER RECORDATION CERTIFICATE Filing Requirement of Act 74, Mich. P.A. 1970

For corners in SECTION

<u>WEXFORD</u> <small>(County)</small>	Located In:	Corner Code #	
1. Public Land Survey	T <u>24N</u> R <u>12W</u>	<u>F-13</u>	
	T _____ R _____	_____	
	T _____ R _____	_____	
	T _____ R _____	_____	
2. Property Controlling in Section	S _____ T _____ R _____	_____	
	S _____ T _____ R _____	_____	
3. Miscellaneous Property in Sec.	S _____ T _____ R _____	_____	
	S _____ T _____ R _____	_____	
4. Lot No. _____, Recorded Plat _____			
5. Private Claims _____			

RECEIVED
1997 DEC 11 AM 9:29
Linda Loughmiller
WEXFORD COUNTY, MI
REGISTER OF DEEDS

Register of Deeds Stamp & File Num

1	A	B	C	D	E	F	G	H	I	J	K	L
2		6		5		4		3		2		1
3												
4		7		8		9		10		11		1
5												
6		18		17		16		15		14		1
7												
8		19		20		21		22		23		2
9												
10		30		29		28		27		26		2
11												
12		31		32		33		34		35		3
13												

I, CRAIG J. PULLEN, in a field survey on APRIL 14, 1997, do hereby state that under requirements of P.A. 74, Michigan P.A. of 1970, the corner points mentioned in lines 1 and 2 above were in conformance with regulations and rules therefore as required in the current manual of survey instructions of the United States Department of the Interior, Bureau of Land Management or by a decree of a Court of Law and/or that the corner points mentioned in lines 3, 4 and 5 above were in conformance with the rules of the Michigan Board of Land Surveyors or by a Decree of a Court of Law; established, re-established, monumented, recovered, found as expressed below:

NOTE: Not more than 2 corners, all in the same town and range, may be recorded on this certificate.


- A. Description of original monument and accessories and/or subsequent restoration:**
- F-13 1838 G.L.O. SURVEY BY J. BRINK, WOOD POST LYNN 8 N77E 40 ELM 9 N52W 28
 - 1977 TEED SURVEY IN SEC.4, T23N, R12W CORNER SHOWN AS IN BUT NO CORNER DESC. OR WITNESSES GIVEN DISTANCE TO 1/8 TO WEST IS 1320.35' AND TO NW COR. SEC. 4, T23N, R12W, 2640.70'
 - 1971 J. ERICKSON PS #16929 L.C.R.C. L. 1, P. 48 FOUND 1" IRON 1' BELOW GRAVEL SURFACE, ACCEPTED THIS CORNER ON BASIS OF MEASUREMENTS TO CORNER FOUND TO THE WEST (NW COR. SEC. 4 FOUND) 1/8 CORNER BETWEEN N1/4 COR & NW CORNER FOUND, SET 1/2" IRON & RLS CAP OVER EXISTING 1" IRON, S20°E 5" J. PINE 72.81' S40°E 6" R. PINE 80.86' DUE NORTH 18" ELM 34.81'
 - 1973 J. ERICKSON PS #16929 L.C.R.C. L. 1, P. 338 FOUND 1/2" IRON & CAP "RLS" 3' WEST OF N-S FENCE, 3' SOUTH OF CENTERLINE OF E-W ROAD, S30°E 6" J. PINE 73.18' DUE NORTH 20" ELM 34.81
 - 1978 J.L. WILCOX PS #14102 L.C.R.C. L. 3, P. 203, FOUND 5/8" RE-ROD W/CAP (DEFACED) AND GOOD OLD FENCE LINE SOUTH, SET WEXFORD COUNTY MONUMENT, WITNESSES SAME AS RECORDED BY J. ERICKSON 19/1

- B. Description of corner evidence found and/or method applied in restoring or reestablishing corner:**
- F-13 FOUND WEXFORD COUNTY MONUMENT IN GOOD CONDITION 3' SOUTH OF CENTERLINE OF 14 ROAD AND 3' WEST OF N-S FENCE AND 3 PREVIOUS WITNESSES. THIS CORNER IS ACCEPTED AS THE BEST AVAILABLE EVIDENCE OF THE POSITION OF THE CORNER.

- C. Description of monument for corner and accessories established to perpetuate locating the position of the corner:**
- F-13 1/4 CORNER COMMON TO SECTION 33, T24N, R12W, AND SECTION 4, T23N, R12W WEXFORD COUNTY MONUMENT STAMPED: CJP, 39095, 1997, 33, 4, 1/4

S4°E	12" JACK PINE	72.36'
S32°E	9" RED PINE	80.83'
N70°E	5" ELM	56.38'
NORTH	1/2" IRON & CAP #31611	33.00'
S3°W	1/2" IRON & CAP	33.00'
NORTH	REMAINS OF ELM STUMP	34.81'

Peer Group Reviewed and Approved
Date: 30 Oct 97
Richard D. Wilcox
Richard D. Wilcox, Wexford County Surveyor

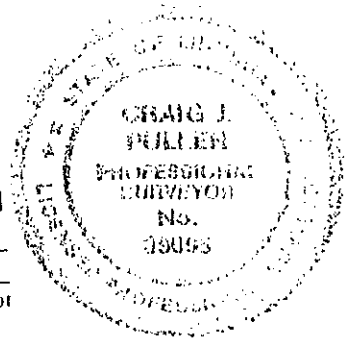

Signed by *Craig J. Pullen*
Surveyor's Michigan License No. 39095

Date December 2, 1997