

SURVEY & REMONUMENTATION

FEB 11 1998

LAND CORNER RECORDATION CERTIFICATE
Filing Requirement of Act 74, Mich. P.A. 1970

SECTION

For corners in

<u>WEXFORD</u> (County)	Located In:	Corner Code #
1. Public Land Survey	T <u>24N</u> R <u>12W</u>	<u>G-13</u>
	T _____ R _____	_____
	T _____ R _____	_____
	T _____ R _____	_____
2. Property Controlling in Section	S _____ T _____ R _____	_____
	S _____ T _____ R _____	_____
3. Miscellaneous Property in Sec.	S _____ T _____ R _____	_____
	S _____ T _____ R _____	_____
4. Lot No. _____, Recorded Plat _____		
5. Private Claims _____		

RECEIVED
1997 DEC 11 AM 9:29

Linda Loughmiller
WEXFORD COUNTY, MI
REGISTER OF DEEDS

Register of Deeds Stamp & File Num

1	A	B	C	D	E	F	G	H	I	J	K	L
2		6		5		4		3		2		
3												
4		7		8		9		10		11		
5												
6		18		17		16		15		14		
7												
8		19		20		21		22		23		
9												
10		30		29		28		27		26		
11												
12		31		32		33		34		35		
13												

I, CRAIG J. PULLEN, in a field survey on MAY 14, 1997, do hereby state that under requirements of P.A. 74, Michigan P.A. of 1970, the corner points mentioned in lines 1 and 2 above were in conformance with regulations and rules therefore as required in the current manual of survey instructions of the United States Department of the Interior, Bureau of Land Management or by a decree of a Court of Law and/or that the corner points mentioned in lines 3, 4 and 5 above were in conformance with the rules of the Michigan Board of Land Surveyors or by a Decree of a Court of Law; established, re-established, monumented, recovered, found as expressed below:

NOTE: Not more than 2 corners, all in the same town and range, may be recorded on this certificate.

A. Description of original monument and accessories and/or subsequent restoration:

- G-13 1838 G.L.O. SURVEY BY J. BRINK, WOOD POST SUGAR 10 N13E 31 SUGAR 30 N37W 21 CLOSING WITNESSES SUGAR 10 S29W 33 SUGAR 13 S27E 65
- 1915 E.E. SOURS COUNTY SURVEYOR RECORDS P. 234,235 NO CORNER DESC. GIVEN MAPLE 10" N71E 19' MAPLE 12" N59"30W 35'
- 1968 WEXFORD COUNTY ROAD COMMISSION 1/2" PIPE 4" DEEP SE 8° RED PINE 123.60' NW 8" MAPLE 70.50' N30"E 12" MAPLE 41.50' BLAZED WITH BOTTLE CAPS
- 1971 J. ERICKSON PS #16929 L.C.R.C. L. 1, P. 49 1/2" STEEL PIPE 4" DEEP W.C.R.C. WITNESSES IN EXISTENCE
- 1973 J. ERICKSON PS #16929 L.C.R.C. L. 1, P. 334 1/2" PIPE N45"W 70.79' 8" MAPLE S40 E 34.23' POWER POLE N75 E 41.94' 14" MAPLE
- 1978 J.L. WILCOX PS #14102 L.C.R.C. L. 3, P. 203, FOUND 1/2" IRON PIPE IN "T" INTERSECTION, SET WEXFORD COUNTY MONUMENT W.C.R.C. WITNESSES IN PLACE AS RECORDED

B. Description of corner evidence found and/or method applied in restoring or reestablishing corner:


- G-13 FOUND WEXFORD COUNTY MONUMENT IN GOOD CONDITION 6' SOUTH OF CENTERLINE OF 7 RD. AND IN CENTERLINE OF 14 RD. AND 2 PREVIOUS WITNESSES. THIS CORNER IS ACCEPTED AS THE BEST AVAILABLE EVIDENCE OF THE POSITION OF THE CORNER.

C. Description of monument for corner and accessories established to perpetuate locating the position of the corner:

- G-13 SECTION CORNER COMMON TO SECTIONS 33 & 34, T24N, R12W, AND SECTIONS 3 & 4, T23N, R12W WEXFORD COUNTY MONUMENT STAMPED: CJP, 39095, 1997, 33, 34, 3, 4
- N40"W 12" MAPLE 71.04'
- N78"E 18" MAPLE 42.35'
- S33"E 24" MAPLE 53.94'
- S44"W POST FOR TEL. PEDESTAL 70.35'

Peer Group Reviewed and Approved:

Date: 30 Oct 97
Richard D. Wilcox
Richard D. Wilcox, Wexford County Surveyor

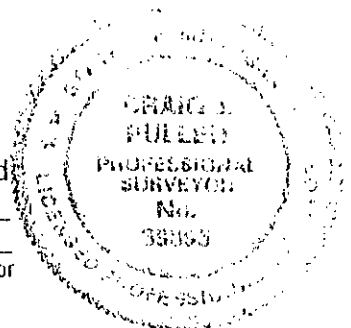

Signed by *Craig Pullen*
Surveyor's Michigan License No. 39095

Date December 2, 1997