

# SURVEY & REMONUMENTATION

FEB 11 1998

## SECTION

## LAND CORNER RECORDATION CERTIFICATE Filing Requirement of Act 74, Mich. P.A. 1970

For corners in

<u>WEXFORD</u> (County)	Located In:	Corner Code #
1. Public Land Survey	T <u>24N</u> R <u>12W</u>	<u>H-13</u>
	T ___ R ___	___
	T ___ R ___	___
	T ___ R ___	___
2. Property Controlling in Section	S ___ T ___ R ___	___
	S ___ T ___ R ___	___
3. Miscellaneous Property in Sec.	S ___ T ___ R ___	___
	S ___ T ___ R ___	___
4. Lot No. _____, Recorded Plat _____		
5. Private Claims _____		

RECEIVED

1997 DEC 11 AM 9:29

*Linda Langhammer*  
WEXFORD COUNTY, MI  
REGISTER OF DEEDS

Register of Deeds Stamp & File Num

	A	B	C	D	E	F	G	H	I	J	K	L
1												
2	6			5		4			3			2
3												
4	7			8		9			10			11
5												
6	18			17		16			15			14
7												
8	19			20		21			22			23
9												
10	30			29		28			27			26
11												
12	31			32		33			34			35
13												

I, CRAIG J. PULLEN, in a field survey on MAY 14, 1997, do hereby state that under requirements of P.A. 74, Michigan P.A. of 1970, the corner points mentioned in lines 1 and 2 above were in conformance with regulations and rules therefore as required in the current manual of survey instructions of the United States Department of the Interior, Bureau of Land Management or by a decree of a Court of Law and/or that the corner points mentioned in lines 3, 4 and 5 above were in conformance with the rules of the Michigan Board of Land Surveyors or by a Decree of a Court of Law; established, re-established, monumented, recovered, found as expressed below:


NOTE: Not more than 2 corners, all in the same town and range, may be recorded on this certificate.

- A. Description of original monument and accessories and/or subsequent restoration:
- H-13 1838 G.L.O. SURVEY BY J. BRINK, WOOD POST HEM 12 N9½W 25 SUGAR 9 N70½E 27
  - 1978, 1980 & 1988 J.L. WILCOX ASSOC. SURVEY BY J.L. WILCOX PS #14102 L. 1, P. 691 & 846, L. 66, P. 506 RESPECTIVELY & L.C.R.C. L. 3, P. 191, FOUND BUGGY AXLE IN FOUR WAY FENCE LINES, SET WEXFORD COUNTY MONUMENT N21° 6' RED PINE 22.82' N70°W 4" RED PINE 45.25' NORTH CORNER FENCE POST 1.25' SOUTH FENCE POST 14.15'
  - 1981 & 1984 J.L. WILCOX ASSOC. SURVEY BY J.L. WILCOX PS #14102 L.1, P. 907 & L. 2, P. 87, WEXFORD COUNTY MONUMENT S25°E 12" MAPLE S35° W 8" MAPLE 26.28 N25°W 6" MAPLE 19.73 S82°E 4" IRONWOOD 32.68'
  - 1989 L.W. SLATER PS #7439 SURVEY L. 67, P. 583, WEXFORD COUNTY MONUMENT WITNESSES SAME AS WILCOX 1988 SURVEY
  - 1996 WILCOX ASSOC. SURVEY BY J.D. GEERS PS #33977 L. 76, P. 305 WEXFORD COUNTY MONUMENT WITNESSES SAME AS 1988 WILCOX SURVEY

- B. Description of corner evidence found and/or method applied in restoring or reestablishing corner:
- H-13 FOUND WEXFORD COUNTY MONUMENT IN GOOD CONDITION 1.25' SOUTH OF EAST-WEST FENCE AND IN LINE WITH NORTH-SOUTH FENCE AND 3 PREVIOUS WITNESSES. THIS CORNER IS ACCEPTED AS THE BEST AVAILABLE EVIDENCE OF THE POSITION OF THE CORNER.

- C. Description of monument for corner and accessories established to perpetuate locating the position of the corner:
- H-13 1/4 CORNER COMMON TO SECTION 34, T24N, R12W, AND SECTION 3, T23N, R12W  
WEXFORD COUNTY MONUMENT STAMPED: CJP, 39095, 1997, 34, 3, 1/4  
N64°W 12" RED PINE 44.57'  
N2°W 9" RED PINE 30.48'  
N88°E 5" CHERRY 83.10'  
S4°W FENCE POST 14.47'

Peer Group Reviewed and Approved  
Date: 30 Oct 97  
*Richard D. Wilcox*  
Richard D. Wilcox, Wexford County Surveyor

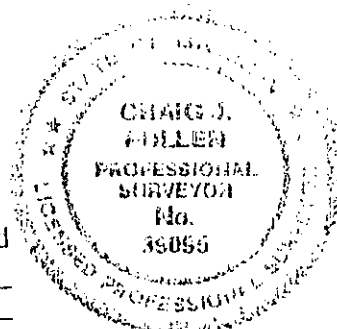

Signed by Craig J. Pullen  
Surveyor's Michigan License No. 39095

Date December 2, 1997