

**SURVEY & REMONUMENTATION**

**FEB 11 1998**

**LAND CORNER RECORDATION CERTIFICATE**  
Filing Requirement of Act 74, Mich. P.A. 1970

**SECTION**

For corners in

<u>WEXFORD</u> (County)	Located In:	Corner Code #
1. Public Land Survey	T <u>24N</u> R <u>12W</u>	<u>L-13</u>
	T _____ R _____	_____
	T _____ R _____	_____
	T _____ R _____	_____
2. Property Controlling in Section	S _____ T _____ R _____	_____
	S _____ T _____ R _____	_____
3. Miscellaneous Property in Sec.	S _____ T _____ R _____	_____
	S _____ T _____ R _____	_____
4. Lot No. _____, Recorded Plat _____		
5. Private Claims _____		

**RECEIVED**  
1997 DEC 11 AM 9:30  
*Linda Loughmiller*  
WEXFORD COUNTY, MI  
REGISTER OF DEEDS

Register of Deeds Stamp & File Number

A	B	C	D	E	F	G	H	I	J	K	L
1											
2	6		5		4		3		2		1
3											
4	7		8		9		10		11		12
5											
6	18		17		16		15		14		13
7											
8	19		20		21		22		23		24
9											
10	30		29		28		27		26		25
11											
12	31		32		33		34		35		36
13											

I, CRAIG J. PULLEN, in a field survey on MAY 19, 1997, do hereby state that under requirements of P.A. 74, Michigan P.A. of 1970, the corner points mentioned in lines 1 and 2 above were in conformance with regulations and rules therefore as required in the current manual of survey instructions of the United States Department of the Interior, Bureau of Land Management or by a decree of a Court of Law and/or that the corner points mentioned in lines 3, 4 and 5 above were in conformance with the rules of the Michigan Board of Land Surveyors or by a Decree of a Court of Law; established, re-established, monumented, recovered, found as expressed below:

**NOTE: Not more than 2 corners, all in the same town and range, may be recorded on this certificate.**

A. Description of original monument and accessories and/or subsequent restoration:

- L-13 1838 G.L.O. SURVEY BY J. BRINK, QUARTER SECTION POST IN RIVER
- 1909 FARGO ENGINEERING SURVEY IN SEC. 1, T23N, R12W NO U.S. EVIDENCE SET IRON PIPE & CROCKERY LYNN 18 S6W 0.935CH ELM 14 S62 3/4E 0.98CH
- 1974, 1975, 1976, J.L. WILCOX & ASSOC. SURVEYS RECORDED IN L. 1, PGS. 250, 615, & 404 RESPECTIVELY, J.L. WILCOX, PS #14102, FOUND IRON S6°W 18" BASSWOOD 61.7' S63°E 14" ELM 64.6'
- 1979 GRANGER ENG. SURVEY BY J. RAY, PS #25869, L. 1, P. 705 FOUND MONUMENT AT EDGE OF RIVER ON PENINSULA N78°E 12" DEAD ELM 21.21' S50°E 10" CEDAR 36.33' N10°W CEDAR CLUMP 28.12'
- 1981 J. RAY, PS #25869 L.C.R.C. L.3, P.243 FOUND MONUMENT AT EDGE OF RIVER WITS. SAME AS 1979 SURVEY
- 1988 J.L. WILCOX & ASSOC. BY J.L. WILCOX, PS#14102, L.66, P.497 MON. BOX EDGE OF WATER WITS. SAME AS 1979 GRANGER ENG. SURVEY
- 1991 & 1996 GRAND TRAVERSE SURVEYING CO. SURVEY BY N. LIVASY, PS#31611 FOUND CONCRETE MONUMENT WITS. SAME AS 1979 GRANGER ENG. SURVEY

B. Description of corner evidence found and/or method applied in restoring or reestablishing corner:


- L-13 FOUND CONCRETE MONUMENT IN EXCELLENT CONDITION AT BOTTOM OF STEEP BANK ON PENINSULA OF MANISTEE RIVER; ADDED BRASS CAP. THIS POSITION NOT ESTABLISHED BY ORIGINAL GOVERNMENT SURVEYORS. THIS CORNER IS ACCEPTED AS THE BEST AVAILABLE EVIDENCE OF THE POSITION OF THE CORNER.

C. Description of monument for corner and accessories established to perpetuate locating the position of the corner:

- L-13 1/4 CORNER COMMON TO SECTION 36, T24N, R12W, AND SECTION 1, T23N, R12W CONCRETE MONUMENT WITH BRASS CAP STAMPED: CJP, 39095, 1997, 36, 1, 1/4
- N14°W QUAD 8" CEDAR 28.34'
- N38°E TRIPLE 8" CEDAR 35.34'
- S80°E 5" POPLAR 28.67'
- S42°E 8" TWIN CEDAR 33.40'

Peer Group Reviewed and Approved

Date: 30 Oct 97  
Richard D. Wilcox  
Richard D. Wilcox, Wexford County Surveyor

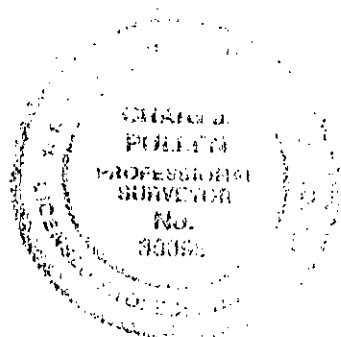

Signed by Craig J. Pullen  
Surveyor's Michigan License No. 39095

Date December 2, 1997