

**SURVEY &
REMONUMENTATION**

RECEIVED

APR 25 1995

**LAND CORNER RECORDATION CERTIFICATE
Filing Requirement of Act 74, Mich. P.A. 1970**

1994 NOV 30 AM 10: 45

For corners in **COMMISSION**
WEXFORD

Linda Loughmiller
WEXFORD COUNTY, MI
REGISTER OF DEEDS

(County)	Located In:	Corner Code #
	24N 12W	M-5
1. Public Land Survey	T _____ R _____	_____
	T _____ R _____	_____
	T _____ R _____	_____
	T _____ R _____	_____
2. Property Controlling in Section	S _____ T _____ R _____	_____
	S _____ T _____ R _____	_____
3. Miscellaneous Property in Sec.	S _____ T _____ R _____	_____
	S _____ T _____ R _____	_____

Register of Deeds Stamp & File Number

4. Lot No. _____, Recorded Plat _____
5. Private Claims _____

	A	B	C	D	E	F	G	H	I	J	K	L	M
2	6		5		4		3		2		1		
3													
4	7		8		9		10		11		12		
5													
6	18		17		16		15		14		13		
7													
8	19		20		21		22		23		24		
9													
10	30		29		28		27		26		25		
11													
12	31		32		33		34		35		36		
13													

CRAIG J. PULLEN JUNE 8 94

I, _____, in a field survey on _____, 19 _____, do hereby certify that under requirements of P.A. 74, Michigan P.A. of 1970, the corner points mentioned in lines 1 and 2 above were in conformance with regulations and rules therefore as required in the current manual of survey instructions of the United States Department of the Interior, Bureau of Land Management or by a decree of a Court of Law and/or that the corner points mentioned in lines 3, 4 and 5 above were in conformance with the rules of the Michigan Board of Land Surveyors or by a Decree of a Court of Law; established, re-established, monumented, re-monumented, recovered, found as expressed below:

NOTE: Not more than 4 corners, all in the same town and range, may be recorded on this certificate.

A. Description of original monument and accessories and/or subsequent restoration:

- M-5 1838 J. BRINKS GLO SURVEY WOOD POST BEACH 8 S29W 13 BEECH 8 N62W 33
1892 TEED SURVEY L.1 P.352. NO WITNESSES GIVEN.
1960 MSHD SURVEY M-37 2" IRON PIPE 2X2 HUBS AT BEARING LINES OF N76°15'W AND N 44°16'E
1982 WM. BATZER #13026 SURVEY L.2 P.17 FOUND IRON IN MON BOX S73°E 135.46' P. POLE N25°W 80.61' SE COR CONC HEADWALL FOR CULVERT
1992 B. JONES #23514 SURVEY L.71 P.615 & 616 FD 1/2" IRON IN MON BOX N73°W P. POLE 155.30' N20°E 8" ELM 174.85' S23°E P. POLE 135.46' N25°W SE COR. OF CONC. HEADWALL FOR CULVERT 80.61'

B. Description of corner evidence found and/or method applied in restoring or reestablishing corner:

- M-5 FOUND BOAT SPIKE IN MON. BOX 2' W. OF CENTERLINE M-37 AND 3 WITNESSES FROM JONES SURVEY L.71 P.615 & 616. SET 5/8" X 24" IRON WITH BRASS CAP IN POSITION OF SPIKE AND LEFT SPIKE ADJACENT TO IRON. THIS CORNER IS ACCEPTED AS A FAITHFUL AND CAREFUL PERPETUATION OF THE POSITION OF THE ORIGINAL CORNER.


Peer Group Reviewed and Approved

Date: 11-21-94

Richard D. Wilcox
Richard D. Wilcox, Wexford County Surveyor

C. Description of monument for corner and accessories established to perpetuate locating the position of the corner:

- M-5 SE CORNER OF SECTION 12, T24N, R12W, NE COR. SEC. 13 T24N R12W, AND THE SW COR SEC. 7, THE NW 5/8" X 24" IRON WITH BRASS CAP STAMPED: CJP, 39095, 1994, SC, 12, 13, 7, 18 (COR SEC. 12 T24N R12W)
N28°W 3" SE CORNER CONCRETE HEADWALL 80.61'
N78°W POWER POLE 155.30'
S60°W TELEPHONE PEDESTAL GUARD POST 69.09'
N16°E 8" ELM 174.85'

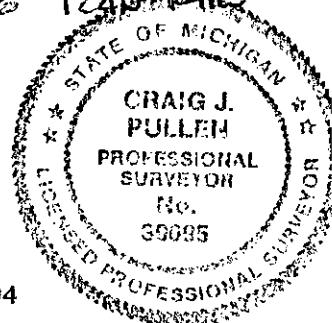

Signed by *Craig J. Pullen* Date SEPTEMBER 22, 1994
Surveyor's Michigan License No. 39095