

**SURVEY & RE-MONUMENTATION**

APR 25 1995

**LAND CORNER RECORDATION CERTIFICATE**  
**Filing Requirement of Act 74, Mich. P.A. 1970**

RECEIVED

1994 NOV 30 AM 10:45

For corners in  
**WEXFORD**

**COMMISSION**

*Linda Longmiller*  
 WEXFORD COUNTY, MI  
 REGISTER OF DEEDS

	Located In:	Corner Code #
1. Public Land Survey	T <u>24N</u> R <u>12W</u>	<u>M-8</u>
	T _____ R _____	_____
	T _____ R _____	_____
	T _____ R _____	_____
2. Property Controlling in Section	S _____ T _____ R _____	_____
	S _____ T _____ R _____	_____
3. Miscellaneous Property in Sec.	S _____ T _____ R _____	_____
	S _____ T _____ R _____	_____

Register of Deeds Stamp & File Number

4. Lot No. \_\_\_\_\_, Recorded Plat \_\_\_\_\_  
 5. Private Claims \_\_\_\_\_

	A	B	C	D	E	F	G	H	I	J	K	L	M
2	6	5	4	3	2	1							
3													
4	7	8	9	10	11	12							
5													
6	18	17	16	15	14	13							
7													
8	19	20	21	22	23	24							
9													
10	30	29	28	27	26	25							
11													
12	31	32	33	34	35	36							
13													

I, CRAIG J. PULLEN, in a field survey on JUNE 1, 1994, do hereby certify that under requirements of P.A. 74, Michigan P.A. of 1970, the corner points mentioned in lines 1 and 2 above were in conformance with regulations and rules therefore as required in the current manual of survey instructions of the United States Department of the Interior, Bureau of Land Management or by a decree of a Court of Law and/or that the corner points mentioned in lines 3, 4 and 5 above were in conformance with the rules of the Michigan Board of Land Surveyors or by a Decree of a Court of Law, established, re-established, monumented, re-monumented, recovered, found as expressed below:

**NOTE: Not more than 4 corners, all in the same town and range, may be recorded on this certificate.**

A. Description of original monument and accessories and/or subsequent restoration:

- M-8 1838 GLO SURVEY BY J. BRINK BEECH 12 IN DIA. FOR QTR. SEC. CORNER
- 1909 GASSER IN ROAD COMMISSION KNOWN CORNER BOOK 5373.9' N OF E 1/4 COR. SEC.25 DATE UNKNOWN - COUNTY ROAD COMMISSION WITNESS BOOK IRON PIPE 0.4' E OF CENTERLINE AND 2664' NORTH OF COR. COMMON TO 24, 25, 19 & 30
- 1980 GRANGER ENG. SURVEY J. RAY #25869, L.1, P.808 FOUND MON. BOX WITH 3/4" ROD 30" MAPLE N81°W 43.00' 24" MAPLE S78°W 46.72' 30" MAPLE S48°W 66.18' 6" MAPLE DUE EAST 30.50'

B. Description of corner evidence found and/or method applied in restoring or reestablishing corner:


- M-8 FOUND 3/4" IRON IN MON. BOX 5' E OF CENTERLINE M-37. REMOVED 3/4" IRON AND SET 5/8" X 24" IRON WITH BRASS CAP IN ITS PLACE. THIS CORNER IS ACCEPTED AS A FAITHFUL AND CAREFUL PERPETUATION OF THE POSITION OF THE ORIGINAL CORNER.

Peer Group Reviewed and Approved

Date: 11-21-94  
*Richard D. Wilcox*  
 Richard D. Wilcox, Wexford County Surveyor

C. Description of monument for corner and accessories established to perpetuate locating the position of the corner:

- M-8 E 1/4 CORNER, SECTION 24, T24N, R12W, AND THE W 1/4 COR. SEC. 19 T24N R12W
- 5/8" X 24" IRON WITH BRASS CAP STAMPED: CJP, 39095, SC, 1/4, 24, 19, 1994
- S18°W 24" HARD MAPLE 128.00'
- S67°E 6" HARD MAPLE 49.00'
- S48°E 12" POPLAR 71.28'
- N35°E 6" TWIN MAPLE 68.09'

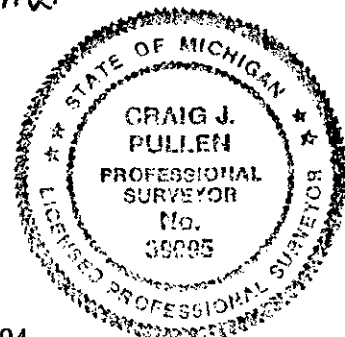

Signed by Craig J. Pullen  
 Surveyor's Michigan License No. 39095

Date SEPTEMBER 22, 1994