

**SURVEY & REMONUMENTATION**

RECEIVED

APR 25 1995

**LAND CORNER RECORDATION CERTIFICATE**  
Filing Requirement of Act 74, Mich. P.A. 1970

1994 NOV 30 AM 10:45

For corners in **COMMISSION**  
WEXFORD

*Linda Longmiller*  
WEXFORD COUNTY, MI  
REGISTER OF DEEDS

	(County)	Located in:		Corner Code #
		24N	12W	
1. Public Land Survey		T	R	M-9
		T	R	
		T	R	
		T	R	
2. Property Controlling in Section	S	T	R	
	S	T	R	
3. Miscellaneous Property in Sec.	S	T	R	
	S	T	R	

Register of Deeds Stamp & File Number

4. Lot No. \_\_\_\_\_, Recorded Plat \_\_\_\_\_  
5. Private Claims \_\_\_\_\_

	A	B	C	D	E	F	G	H	I	J	K	L	M
2	6	5	4	3	2	1							
3													
4	7	8	9	10	11	12							
5													
6	18	17	16	15	14	13							
7													
8	19	20	21	22	23	24							
9													
10	30	29	28	27	26	25							
11													
12	31	32	33	34	35	36							
13													

CRAIG J. PULLEN

JUNE 2

94

I, \_\_\_\_\_, in a field survey on \_\_\_\_\_, 19 \_\_\_\_\_, do hereby certify that under requirements of P.A. 74, Michigan P.A. of 1970, the corner points mentioned in lines 1 and 2 above were in conformance with regulations and rules therofore as required in the current manual of survey instructions of the United States Department of the Interior, Bureau of Land Management or by a decree of a Court of Law and/or that the corner points mentioned in lines 3, 4 and 5 above were in conformance with the rules of the Michigan Board of Land Surveyors or by a Decree of a Court of Law; established, re-established, monumented, re-monumented, recovered, found as expressed below:

**NOTE: Not more than 4 corners, all in the same town and range, may be recorded on this certificate.**

A. Description of original monument and accessories and/or subsequent restoration:

- M-9 1838 GLO SURVEY BY J. BRINK WOOD POST BEECH 12 S42W 22 BEECH 10 N36W 35
- 1915 FARGO ENG. SURVEY, FOUND STAKE SET IN CENTER OF GRAVEL ROAD N&S - ACCEPTED BEECH 16" N22E 1.14 1/2 SUGAR 12" N26 1/4 W 0.71
- 1960 MSHD SURVEY M-37 3/4" IRON PIPE 2X2 HUBS WITNESSED N38E 68.92 + 85.30 S38°W 91.80 + 39.14 S44°30'E 76.28 + 31.83'
- 1979 D. HOOTH #7966 L.C.R.C. L.3 P.210 ACCEPTED A BOAT SPIKE IN MON. BOX IN CENTERLINE M-37 AT 10 ROAD DUE EAST 107.02' 10" MAPLE N75E 88.05' 11" CHERRY N60°E 120.78' 20" ASH
- 1980 GRANGER ENG. SURVEY J. RAY #25869 L.1 P.808 FOUND MON. BOX WITH 1" BAR 6" ELM S86°W 50.50' 6" MAPLE DUE EAST 107.03' (TAG) 8" CHERRY 88.04' (TAG) 16" TWIN MAPLE N58°E 120.72' (TAG)

B. Description of corner evidence found and/or method applied in restoring or reestablishing corner:


M-9 FOUND BOAT SPIKE IN MON. BOX 1.0 W OF CENTERLINE M-37 AND 1 WITNESS FROM L.1 P.808. SET 5/8" X 24" IRON WITH BRASS CAP IN POSITION OF SPIKE AND LEFT SPIKE ADJACENT TO IRON. THIS CORNER IS ACCEPTED AS A FAITHFUL AND CAREFUL PERPETUATION OF THE POSITION OF THE ORIGINAL CORNER.

Peer Group Reviewed and Approved

Date: 11-21-94  
*R. D. Wilcox*  
Richard D. Wilcox, Wexford County Surveyor

C. Description of monument for corner and accessories established to perpetuate locating the position of the corner:

- M-9 NE CORNER, SECTION 25, T24N, R12W, SE COR. SEC. 24 T24N R12W, AND THE SW COR. SEC. 19, SE NW COR. SEC. 30 T24N R12W
- 5/8" X 24" IRON WITH BRASS CAP STAMPED: CJP, 39095, 1994, SEC. 24, 25, 19, 30
- N89°W 1/2" CAPPED IRON 33.00'
- N18°E 22" ASH 134.30'
- N56°E 16" ASH 120.75'
- N82°E 24" CHERRY 99.64'

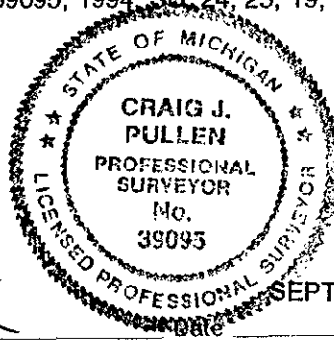

SEPTEMBER 22, 1994

Signed by *Craig J. Pullen*

39095

Surveyor's Michigan License No. \_\_\_\_\_