

**SURVEY &
REMONUMENTATION**

RECEIVED

APR 25 1995

LAND CORNER RECORDATION CERTIFICATE
Filing Requirement of Act 74, Mich. P.A. 1970

1994 NOV 30 AM 10:45

For corners in **COMMISSION**
WEXFORD

Linda Laughmiller
WEXFORD COUNTY, MI
REGISTER OF DEEDS

(County)	Located In:	Corner Code #
1. Public Land Survey	T <u>24N</u> R <u>12W</u>	<u>M-10</u>
	T _____ R _____	_____
	T _____ R _____	_____
	T _____ R _____	_____
2. Property Controlling in Section	S _____ T _____ R _____	_____
	S _____ T _____ R _____	_____
3. Miscellaneous Property in Sec.	S _____ T _____ R _____	_____
	S _____ T _____ R _____	_____

Register of Deeds Stamp & File Number

4. Lot No. _____, Recorded Plat _____
5. Private Claims _____

	A	B	C	D	E	F	G	H	I	J	K	L	M
2	6	5	4	3	2	1							
3													
4	7	8	9	10	11	12							
5													
6	18	17	16	15	14	13							
7													
8	19	20	21	22	23	24							
9													
10	30	29	28	27	26	25							
11													
12	31	32	33	34	35	36							
13													

CRAIG J. PULLEN

JUNE 1

94

I, _____, in a field survey on _____, 19____, do hereby certify that under requirements of P.A. 74, Michigan P.A. of 1970, the corner points mentioned in lines 1 and 2 above were in conformance with regulations and rules therefore as required in the current manual of survey instructions of the United States Department of the Interior, Bureau of Land Management or by a decree of a Court of Law and/or that the corner points mentioned in lines 3, 4 and 5 above were in conformance with the rules of the Michigan Board of Land Surveyors or by a Decree of a Court of Law; established, re-established, monumented, re-monumented, recovered, found as expressed below:

NOTE: Not more than 4 corners, all in the same town and range, may be recorded on this certificate.

A. Description of original monument and accessories and/or subsequent restoration:

- M-10 1838 GLO SURVEY BY J. BRINK WOOD POST, BEECH 10 S41W 72 BEECH 6 N12W 23
- 1909 GASSER 5373.9' SOUTH OF E 1/4 SEC. 24
- 1915 FARGO ENG. SURVEY FOUND STAKE AND CROCKERY IN CENTER OF ROAD. ACCEPTED CEDAR POST 7" E 0.50 1/2 TELEGRAPH POLE 9" S26W 0.72
- 1960 MSHD SURVEY M-37 2 X 2 HUBS N44°W 97.62 + 63.56 S59°30'W 69.09 + 88.80 N59°30'E 63.43 + 82.48'
- 1979 D. HOOTH #7966 L.C.R.C. L.3 P.211 ACCEPTED A BOAT SPIKE AT THE INT. OF NO. 10 1/2 RD & M-37 S65°W 72.26' 6" R. PINE N50°W 64.36' 15" POPLAR N25°W 82.82 26" POPLAR

B. Description of corner evidence found and/or method applied in restoring or reestablishing corner:

M-10 FOUND BOAT SPIKE IN MON. BOX IN CENTERLINE OF M-37 AND 2 WITNESSES FROM L.C.R.C. L.3 P.211 SET 5/8" X 24" IRON WITH BRASS CAP IN POSITION OF SPIKE AND LEFT SPIKE ADJACENT TO IRON. THIS CORNER IS ACCEPTED AS A CAREFUL AND FAITHFUL PERPETUATION OF THE POSITION OF THE ORIGINAL CORNER.


Peer Group Reviewed and Approved

Date: 11-21-94

Richard D. Wilcox
Richard D. Wilcox, Wexford County Surveyor

C. Description of monument for corner and accessories established to perpetuate locating the position of the corner:

- M-10 E 1/4, SECTION 25, T24N, R12W, ADD THE W/4 SEC. 30 T24N R12W
- 5/8" X 24" IRON WITH BRASS CAP STAMPED: CJP, 39095, SC, 1994, 25, 30
- N89°E FENCE POST 49.20'
- S60°W 6" RED PINE 72.27'
- N48°W 16" POPLAR 64.29'
- S67°E 6" BLUE SPRUCE 63.20'

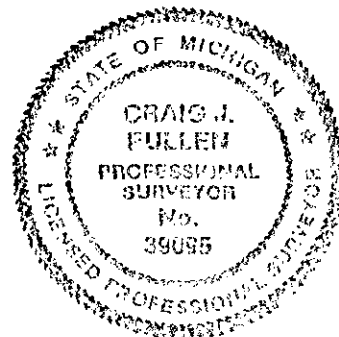

Signed by *Craig J. Pullen*
Surveyor's Michigan License No. 39095

SEPTEMBER 22, 1994

Date _____