

**SURVEY & REMONUMENTATION**

APR 25 1995

COMMISSION

LAND CORNER RECORDATION CERTIFICATE 1994 NOV 30 AM 10:45  
Filing Requirement of Act 74, Mich. P.A. 1970

For corners in  
**WEXFORD**

(County)

Located In:

Corner Code #

- |                                    |   |     |   |     |      |
|------------------------------------|---|-----|---|-----|------|
| 1. Public Land Survey              | T | 24N | R | 12W | M-11 |
|                                    | T |     | R |     |      |
|                                    | T |     | R |     |      |
|                                    | T |     | R |     |      |
| 2. Property Controlling in Section | S |     | T | R   |      |
|                                    | S |     | T | R   |      |
| 3. Miscellaneous Property in Sec.  | S |     | T | R   |      |
|                                    | S |     | T | R   |      |

*Heidi Langhammer*  
WEXFORD COUNTY, MI  
REGISTER OF DEEDS

Register of Deeds Stamp & File Number

4. Lot No. \_\_\_\_\_, Recorded Plat \_\_\_\_\_  
5. Private Claims \_\_\_\_\_

	A	B	C	D	E	F	G	H	I	J	K	L	M
2	6	5	4	3	2	1							
3													
4	7	8	9	10	11	12							
5													
6	18	17	16	15	14	13							
7													
8	19	20	21	22	23	24							
9													
10	30	29	28	27	26	25							
11													
12	31	32	33	34	35	36							
13													

**CRAIG J. PULLEN** in a field survey on **JUNE 1**, 19**94**

do hereby certify that under requirements of P.A. 74, Michigan P.A. of 1970, the corner points mentioned in lines 1 and 2 above were in conformance with regulations and rules therefore as required in the current manual of survey instructions of the United States Department of the Interior, Bureau of Land Management or by a decree of a Court of Law and/or that the corner points mentioned in lines 3, 4 and 5 above were in conformance with the rules of the Michigan Board of Land Surveyors or by a Decree of a Court of Law; established, re-established, monumented, re-monumented, recovered, found as expressed below:

**NOTE: Not more than 4 corners, all in the same town and range, may be recorded on this certificate.**

A. Description of original monument and accessories and/or subsequent restoration:

- M-11 1838 GLO SURVEY BY J. BRINK WOOD POST SUGAR 14 S46½W 22 SUGAR 14 N4W 25  
1915 FOUND REMAINS OF ONE U.S.-WITNESS ELM 5" S7½E 0.69 3/4 TELEGRAPH POLE 9" S49W 1.06  
TELEGRAPH POLE 11" N29 3/4 W 1.45  
1979 MSHD SURVEY L.C.R.C. L.3 P.209 FOUND ½" PIPE WITH COUPLING IN MON. BOX 9.3' EAST OF PAVEMENT. N85°E 56.28' P. POLE N75°E 42.02' 24" APPLE S50°E 38.7' FACE OF 4" BLUE SPRUCE  
1981 J. RAY #25869 L.C.R.C. L.3 P.243 FOUND MON. BOX 6" DEEP 1" PIPE 21.0' E OF CENTERLINE M-37 20" APPLE N73°E 42.00' P. POLE N89°E 56.32' FENCE COR. S88°W 56.90'  
1988 WILCOX & ASSOC. SURVEY D. SCHRIPEMA #24617 L.66 P.513 WEX. CO. MON. N85°E 56.28' P. POLE N75°E 42.02' 24" APPLE S50°E 38.7' 4" SPRUCE S79°W 58.15' FENCE POST

B. Description of corner evidence found and/or method applied in restoring or reestablishing corner:

- M-11 FOUND ½" PIPE WITH COUPLING IN MON. BOX EAST OF M-37. REMOVED PIPE AND SET 5/8" X 24" IRON WITH BRASS CAP IN ITS PLACE. THIS CORNER IS ACCEPTED AS A CAREFUL AND FAITHFUL PERPETUATION OF THE POSITION OF THE ORIGINAL CORNER.


Peer Group Reviewed and Approved

Date: 11-21-94

*Richard D. Wilcox*  
Richard D. Wilcox, Wexford County Surveyor

C. Description of monument for corner and accessories established to perpetuate locating the position of the corner:

- M-11 NE CORNER, SECTION <sup>30</sup> 26, T24N, R12W, SE CORNER SECTION 25 T24N R12W, AND SW COR. SEC. 30, 5/8" X 24" IRON WITH BRASS CAP STAMPED: CJP, 39095, SC, 1994, 25, 36, 30, 31 NW COR. SEC. 31 T24N R12W
- |       |                 |        |
|-------|-----------------|--------|
| N89°E | P. POLE         | 56.32' |
| N33°E | 10" BLUE SPRUCE | 45.26' |
| S34°E | 12" BLUE SPRUCE | 51.00' |
| N86°W | 10" POPLAR      | 49.22' |

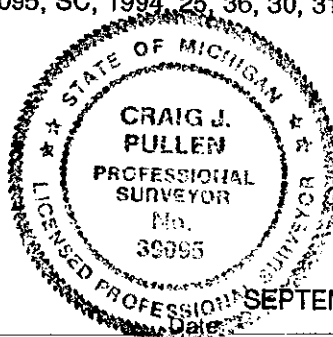

Signed by *Craig J. Pullen*  
Surveyor's Michigan License No. 39095

SEPTEMBER 22, 1994