


**LAND CORNER RECORDATION CERTIFICATE**  
Filing Requirement of Act 74, Mich. PA 1970

For Corners In: <u>Wexford</u> (County)	Located In	Corner Code #
1. Public Land Survey	T <u>24N</u> R <u>12W</u>	<u>E11</u>
2. Property Controlling in Section	S _____ T _____ R _____	_____
3. Miscellaneous Property in Section	S _____ T _____ R _____	_____
4. Lot No: _____	Recorded Plat: _____	
5. Private Claims: _____		

Register of Deeds Stamp & File Number

I, Craig W. McVean, in a field survey on May 21, 2008 do hereby state that under requirements of PA 74, Michigan PA of 1970, the corner points mentioned in lines 1 and 2 above were in conformance with regulations and rules therefore as required in the current manual of survey instructions of the United States Department of the Interior, Bureau of Land Management or by a decree of a Court of Law and/or that the corner points mentioned in lines 3, 4 and 5 above were in conformance with the rules of the Michigan Board of Land Surveyors or by a Decree of a Court of Law; established, re-established, monumented, recovered, found as expressed below:

**NOTE: Not more than 2 corners, all in the same town and range, may be recorded on this certificate.**

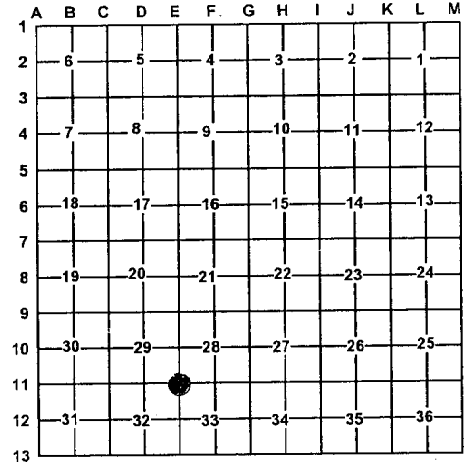

**A. Description of original monument and accessories and/or subsequent restoration:**

- E11 – 1839 – GLO Survey by J. Brink, post  
 1) Beech 12" N38½°E 12 L.  
 2) Hemlock 14" S13°W 23 L.  
 - 1913 – E. E. Sours, County Surveyor, survey in Section 29. All evidence of a corner had been destroyed by fire. As the original survey was so inaccurate I could not depend on alignment. Set both Sec. corners on this line by measurements from adjacent corners. Measured the three miles on this line from center of Township West to Co. line. Measured distance from NE corner of Section to Town Line on South. Doubled distance from Sec. corner 33, 34, 27, & 28 to ¼ post West. Doubled distance from Sec. Cor. 32 & 33 to ¼ post North and set corner to 32, 33, 28 & 29. Set square buggy axle witnessed by stones bearing and dis. 3) S45°E 30 ft.; 4) N45°W 30 ft. Distance West 2685.00'. Distance North 2657.5'.  
 - 2006 – LCRC – L. 7, p. 57 – J. R. Davidson – Found railroad spike at intersection of old barbed wire fence East-West and old barbed wire fence to North. Railroad spike fit position of Sours measurements to North and West. No GLO witnesses or the Sours witness found. Set 5/8" x 36" iron & brass cap in position of railroad spike. Distance North measures 2639.97' (2657.5' – Sours). Distance West to 1/8 corner believed to be "iron Stake" set by Sours measures 1332.28' (1342.5' – Sours) distance to D-11 measures 2660.90' (2685' – Sours). This corner is accepted as the best available evidence of the position of the original corner. 5/8" x 36" iron & brass cap stamped: 2006, JRD, 28, 29, 32 & 33. 5) N10°E 15" Maple, found nail 28.22'; 6) S22°E 10" Maple, found nail 7.00'; 7) S64°W 18" Maple, found nail 31.16'; 8) N52°W 14" Maple, found nail 18.72'

**B. Description of corner evidence found and/or method applied in restoring or re-establishing corner:**

E11 – Section corner common to Sections 28, 29, 32, & 33 – On May 21, 2008 – J. R. Davidson, DNR Survey crew members David Vail, Matt Dontz and I investigated this corner position. Found a brace wire grown in trees 4.5' South of the apparent intersection of fence remains N, E & W. Dug and found ancient wood post bottom and cavity that fits occupation and E. E. Sours monumentation as follows: N2°08'22"E 2640.44' (2640' – GLO, 2657.5' – EES) to 'E10'. S87°58'17"E 2527.74' (2635.38' – GLO) to 'F11'; S3°17'11"W 2746.70' (2640' – GLO) to 'E11' and thence N89°43'49"W 1333.50' (1342.5' – EES) to Fd. 1 ¼" iron bar per E. E. Sours at the E 1/16 Cor. and thence N89°42'03"W 1334.60' (1342.5' – EES) to 'D11'. Ancient post bottom and cavity accepted as the best available evidence of the position of the original corner.

- Reference Pt. – N75°35'W 2.63' to found 1 ½" Wexford Co. Brass Cap on 5/8" x 36" rebar per LCRC L. 7, p. 57. This position replaced a railroad spike of unknown origin. Found another RR spike close to this area. Wexford County Monument not utilized as 'E11' in this survey. J. R. Davidson replaced Wexford Co. Monument with spike.

**C. Description of monument for corner and accessories established to perpetuate locating the position of the corner:**

E11 – J. R. Davidson reset 1 ½" Wexford County Brass Cap on 5/8" x 36" rebar into centerline of found wood post remains.  
 Set Blue Carsonite Post 1' W.  
 N1°E 28.56' to found Nail in East side 16" Ash (#5)  
 N60°W 21.00' to set nail in Northeast side 16" Sugar Maple (#8)  
 S60°W 32.96' to found Nail in Northwest side 18" Ash (#7)  
 S5°E 5.41' to found Nail in East side 10' Sugar Maple (#6)  
 S74°E 46.43' to set nail and tag in North side 14" Beech  
 N75°35'W 2.63' to Reference Point – spike

Signed by: Craig W. McVean  
 Surveyor's Michigan License No.: 39088

Date: 10/23/2008

