


LAND CORNER RECORDATION CERTIFICATE

Filing Requirement of Act 74, Mich. PA 1970

For Corners In: Wexford (County)	Located In	Corner Code #
1. Public Land Survey	T <u>24N</u> R <u>12W</u>	<u>G9</u>
	T _____ R _____	_____
2. Property Controlling in Section	S _____ T _____ R _____	_____
	S _____ T _____ R _____	_____
3. Miscellaneous Property in Section	S _____ T _____ R _____	_____
	S _____ T _____ R _____	_____

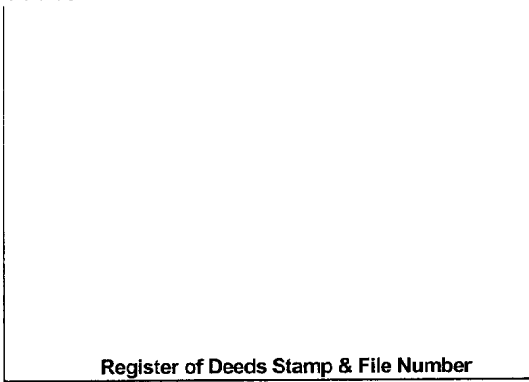


4. Lot No: _____ Recorded Plat: _____

5. Private Claims: _____

I, Craig W. McVean, in a field survey on May 21, 2008 do hereby state that under requirements of PA 74, Michigan PA of 1970, the corner points mentioned in lines 1 and 2 above were in conformance with regulations and rules therefore as required in the current manual of survey instructions of the United States Department of the Interior, Bureau of Land Management or by a decree of a Court of Law and/or that the corner points mentioned in lines 3, 4 and 5 above were in conformance with the rules of the Michigan Board of Land Surveyors or by a Decree of a Court of Law; established, re-established, monumented, recovered, found as expressed below:

NOTE: Not more than 2 corners, all in the same town and range, may be recorded on this certificate.

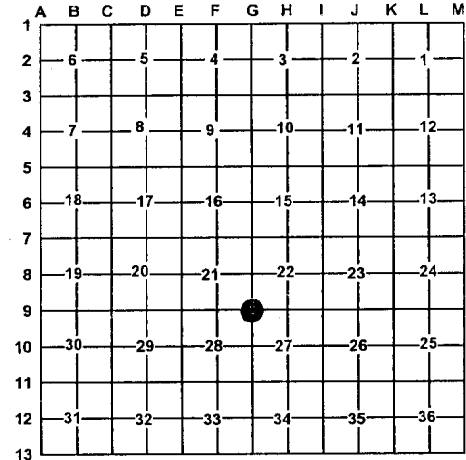

A. Description of original monument and accessories and/or subsequent restoration:

G9 – 1839 – GLO Survey by J. Brink, set post. 1) Lynn 8" S37°E 21; 2) Sugar 14" N66° 30
 - 1901 – H. I. Devoe. No description or witnesses stated. Distance East 2659.14'.
 - 1916 – County Surveyor Records – L. 2, p. 104 – W. A. Johnson – 3) F.P. NW 34½; 4) F.P. SE 42; 5) 18" Cherry SW 81'. This stake established by producing the line of ¼ post 21-22, and South 1/8 post 21-22 and doubling distance of same. This checks reasonably well with existing property lines and testimony of Chas. Randall and other residents. (See P. 110)
 - 1916 - County Surveyor records – L. 2, p. 110 – W. A. Johnson – had been lost by grading. Produced the line of 6 (1/4 21/22) and 12 (S 1/16 21/22) and doubled the distance. Established wooden stk.
 - 1916 – County Survey Record – L. 2, p. 108 E. E. Sours – See pg. 110. Distance South 2787'
 - 1992 – Mitchell & Associates – unrecorded survey in Sec. 28, ½" iron in centerline of Road, distance South 2776.44'.
 - 1999 – McNeely & Lincoln Associates – Field notes in Sec. 28 – ½" Iron rod. – 6) 9" Cherry S70°E 54.31'; 7) 8" Pine S43°E 81.74'; 8) Metal fence post ROW marker N85°W 33'; 9) U. Pole w/Transformer N34°W 179.59'; Distance South 2776.44'
 - 2006 – LCRC – L. 7, p. 61 – J. R. Davidson – Found ½" iron in centerline of 7 Road and 1999 witnesses. Distance South measures 2776.41' compares to 2776.32' – RFM and 2776.44' - MLA. Replaced ½" iron with 5/8" x 36" rebar & Wexford County brass cap. This corner is accepted as the best available evidence of the position of the original corner. 5/8" x 36" rebar and Wexford County Brass Cap stamped: 46659, 21, 22, 27, 28. 6) S74°E 6" Cherry (Set nail over old nail) 54.45'; 7) S46°E 6" Pine (Set nail over old nail) 81.65'; 9) S70°W 6" Cherry (Found nail) 38.59'; 8) N88°W Steel fence post 32.91'; 10) N03°W 16" Twin Elm (set nail) 194.17'

B. Description of corner evidence found and/or method applied in restoring or re-establishing corner:

G9 – Section corner common to 21, 22, 27 & 28 – On May 21, 2008 - J. R. Davidson, DNR Survey crew & I investigated corner location. From 'G8' measured grid bearing and distance of S1°24'03"W 1334.24' to found 2 ½" iron pipe – 2' deep at S 1/16 corner noted by W. A. Johnson. Doubled line and distance S1°24'03"W 1334.24' for position of 'G9' per W. A. Johnson. This position falls in big cut slope of road 7± East of physical centerline of N-S gravel road. Dug here but stake long gone. No evidence of witnesses #1 through 5. Thus J. R. Davidson and DNR survey Crew reset 1 ½" Wexford Co. Brass Cap on 5/8" x 36" rebar at W. A. Johnson position as noted. Also measured S3°57'56"W 1389.24' to found 1 ¾" solid iron at apparent N 1/16 Sec. 28/27 and S3°56'07"W 2776.95' (2640' – GLO, 2787' – EES) to 'G10'. Wexford Co. Monument accepted as a careful and faithful reestablishment of the position of the original corner.

- Reference Pt. – From 'G9' measured S87°09'W 7.29' to found 1 ½" Wexford Co. Brass Cap on 5/8" x 36" rebar per LCRC - L. 7, p. 61 – This position doesn't conform with the County surveyor record and is not utilized as 'G9' in this survey. J. R. Davidson replaced Wexford Co. Monument w/ ½" x 18" rebar. During this process another ½" rebar was found 0.25' East.

C. Description of monument for corner and accessories established to perpetuate locating the position of the corner:

G9 – 1 ½" Wexford County Brass Cap on 5/8" x 36" rebar with 4" x 10" PVC with concrete around cap – Down 9"
 S73°E 47.56' to found nail in North side 6" Cherry in Clp. (#6)
 S45°E 76.82' to found nail in Northeast side Twin 6" Scotch Pine (#7)
 S73°W 45.59' to found nail in South side 7" Cherry (#9)
 N8°W 194.40' to found nail in East side Twin 12" and 14" Elm (#10)
 S87°W 7.04' to found ½" rebar
 S87°09'W 7.29' to Reference Pt. – ½" x 18" rebar

Signed by: Craig W. McVean
 Surveyor's Michigan License No.: 39088

Date: 10/23/2008

