

LAND CORNER RECORDATION CERTIFICATE

Filing Requirement of Act 74, Mich. PA 1970

For Corners In:
Wexford
 (County)

Located In _____ Corner Code # _____


1. Public Land Survey	T	<u>24N</u>	R	<u>12W</u>	<u>F9</u>
	T	_____	R	_____	_____
2. Property Controlling in Section	S	_____	T	_____	R
	S	_____	T	_____	R
3. Miscellaneous Property in Section	S	_____	T	_____	R
	S	_____	T	_____	R

4. Lot No: _____ Recorded Plat: _____

5. Private Claims: _____

I, Craig W. McVean, in a field survey on May 21, 2008 do hereby state that under requirements of PA 74, Michigan PA of 1970, the corner points mentioned in lines 1 and 2 above were in conformance with regulations and rules therefore as required in the current manual of survey instructions of the United States Department of the Interior, Bureau of Land Management or by a decree of a Court of Law and/or that the corner points mentioned in lines 3, 4 and 5 above were in conformance with the rules of the Michigan Board of Land Surveyors or by a Decree of a Court of Law; established, re-established, monumented, recovered, found as expressed below:

NOTE: Not more than 2 corners, all in the same town and range, may be recorded on this certificate.

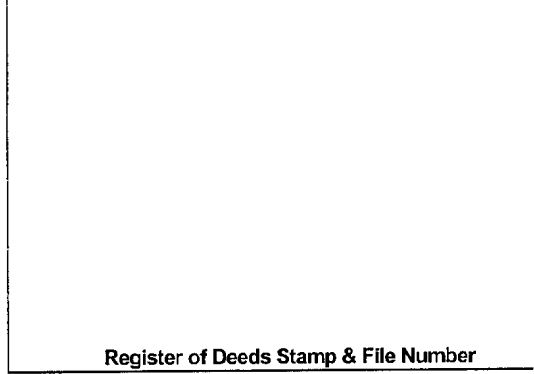

	A	B	C	D	E	F	G	H	I	J	K	L	M
1													
2		6		5		4		3		2		1	
3													
4		7		8		9		10		11		12	
5													
6		18		17		16		15		14		13	
7													
8		19		20		21		22		23		24	
9						●							
10		30		29		28		27		26		25	
11													
12		31		32		33		34		35		36	
13													

A. Description of original monument and accessories and/or subsequent restoration:

- | | |
|--|--|
| <p><u>F9</u> – ¼ Corner common to Sections 21 & 28.</p> <ul style="list-style-type: none"> - 1839 – GLO – J. Brink – set post 1) Beech 10 N73°E 30 L. 2) Beech 6 S58°E 13 L. - 1999 – McNeeley & Lincoln Associates, field notes. Set hub at N ¼ ± fence, remains to South & West Dist. East = 2634.27' Dist. To C ¼ Section 28 = 2767.31' | <ul style="list-style-type: none"> - 2006 – Remon. LCRC, L. 7, p. 59 - J. R. Davidson. Found no evidence of GLO. Set 5/8" iron with Wexford Co. brass cap at single proportion which is 56' South of hub set by McNeely & Assoc. The position is 7' north of centerline Road E-W and 70' West of powerline. 3) N35°E 14" Maple 2.89' 4) S85°E 8" Ironwood 13.24' 5) S44°W 12" Twin Maple 17.71' 6) N80°W 12" Maple 31.41' |
|--|--|

B. Description of corner evidence found and/or method applied in restoring or re-establishing corner:

F9 – ¼ corner common to Sections 21 & 28. – On May 21, 2008 – J.R. Davidson, DNR Survey Crew & I reset 1½" Wexford County Brass Cap on 5/8" x 36" rebar at single proportional position between 'E9' and revised position per County Surveyor Records of 'G9'. Grid Distance East and West is 2639.12' (2637.36' - GLO). Reset 1½" Brass Cap monument accepted as a careful and faithful reestablishment of the position of the original corner.

-Reference Point- S85°59'W 3.64' from 'F9' found 1½" Wexford Co. Brass Cap monument per LCRC L. 7, P. 59. This position was established by single proportion between 'E9' and rejected position at 'G9'. Wexford Co. monument not utilized as 'F9' in this survey. J.R. Davidson removed Wexford Co. monument and replaced with spike.

C. Description of monument for corner and accessories established to perpetuate locating the position of the corner:

- F9 – 1 ½" stamped Wexford Co. Brass Cap on 5/8" x 36" rebar.
- Set Blue Carsonite Post 1' East
 - N86°E 9.40' to found nail in North side 7" Ironwood (#4)
 - S43°W 20.26' to found nail in Southeast side twin 12" Sugar Maple (#5)
 - N87°W 34.93' to found nail in South side 12" triple Sugar Maple (#6)
 - N53°W 3.66' to set nail & tag in Northeast side 18" Sugar Maple
 - S85°59'W 3.64' to Reference Pt. – spike



Signed by: Craig W. McVean
 Surveyor's Michigan License No.: 39088

Date: 10/23/2008