

LAND CORNER RECORDATION CERTIFICATE

Filing Requirement of Act 74, Mich. PA 1970

For Corners In: Wexford Located In _____ Corner Code # _____
(County)

- | | | | | | |
|--------------------------------------|-------------|--------------|--------------|--|-----------|
| 1. Public Land Survey | T _____ | R _____ | | | |
| | T _____ | R _____ | | | |
| 2. Property Controlling in Section | S <u>21</u> | T <u>24N</u> | R <u>12W</u> | | <u>1</u> |
| | S <u>21</u> | T <u>24N</u> | R <u>12W</u> | | <u>12</u> |
| 3. Miscellaneous Property in Section | S _____ | T _____ | R _____ | | |
| | S _____ | T _____ | R _____ | | |


4. Lot No: _____ Recorded Plat: _____

5. Private Claims: _____

I, Craig W. McVean, in a field survey on May 28, 2008 do hereby state that under requirements of PA 74, Michigan PA of 1970, the corner points mentioned in lines 1 and 2 above were in conformance with regulations and rules therefore as required in the current manual of survey instructions of the United States Department of the Interior, Bureau of Land Management or by a decree of a Court of Law and/or that the corner points mentioned in lines 3, 4 and 5 above were in conformance with the rules of the Michigan Board of Land Surveyors or by a Decree of a Court of Law; established, re-established, monumented, recovered, found as expressed below:

NOTE: Not more than 2 corners, all in the same town and range, may be recorded on this certificate.

Register of Deeds Stamp & File Number

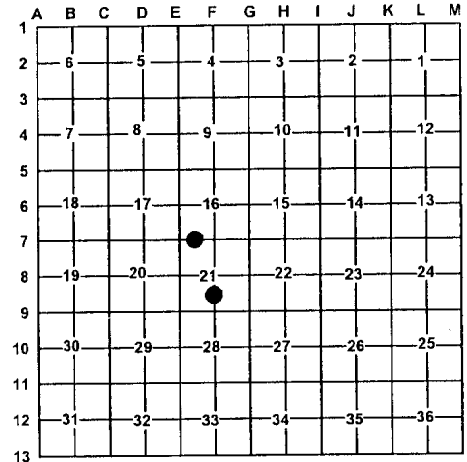

A. Description of original monument and accessories and/or subsequent restoration:

- | | |
|---|--------------------------|
| <p><u>1</u> - 1977 - LCRC - L. 3, p. 122 & DNR project #75-38, Carl F. Roser. Established per BLM procedure. Set 1 1/4" x 30" pipe and cedar post with location tag.</p> <ul style="list-style-type: none"> 1) 12" Maple N03°W 11.3' 2) 9" Maple S13°W 18.8' 3) 8" Maple S81°W 20.8' 4) 12" Maple N73°E 24.5' | <p><u>12</u> - None.</p> |
|---|--------------------------|

B. Description of corner evidence found and/or method applied in restoring or re-establishing corner:

- | | |
|--|---|
| <p><u>1</u> - W 1/16 Cor. Common to Sections 16 & 21 - Found 1 1/4" iron pipe, up 8" per LCRC L.3, p. 122. Accepted 1 1/4" iron pipe as best available evidence of the position of the corner. The distances on witnesses #2 & #3 were reversed. Fd. Stp. of Witness #1.</p> | <p><u>12</u> - CS 1/16 Cor., Section 21 - Set stamped 2" Aluminum cap on 5/8" x 34" rebar per Standard BLM procedure. Found fence remains in all directions. E-W fence is crooked and in trees. N-S fence - East 16'; E-W fence in trees, South 23'</p> |
|--|---|

C. Description of monument for corner and accessories established to perpetuate locating the position of the corner:

- | | |
|---|--|
| <p><u>1</u> - Drove stamped 2" Aluminum cap on 5/8" x 34" rebar into center of 1 1/4" iron pipe & drove down to ground level. Reset cedar post with location tag 1' Southwest</p> <ul style="list-style-type: none"> N72°E 24.67' to set nail & tag in S side 18" Sugar Maple(#4) S10°W 21.23' to set nail & tag in W side 14" Sugar Maple(#2) S79°W 19.34' to set nail & tag in S side 13" Sugar Maple(#3) N65°W 52.24' to set nail & tag in NE side 14" Sugar Maple South 0.5' to Steel Post | <p><u>12</u> - Stamped 2" Aluminum cap on 5/8" x 34" rebar</p> <ul style="list-style-type: none"> Set Blue Carsonite post with location tag 1' SW S17°W 31.51' to set nail & tag in W. side 13" Sugar Maple S60°W 37.94' to set nail & tag in NW side 18" Sugar Maple N55°W 42.54' to set nail & tag in NE side 26" Sugar Maple N21°E 17.37' to set nail & tag in SE side 24" Sugar Maple |
|---|--|

Signed by: Craig W. McVean
Surveyor's Michigan License No.: 39088

Date: 4/14/2009

