


LAND CORNER RECORDATION CERTIFICATE

Filing Requirement of Act 74, Mich. PA 1970

| | | | |
|--------------------------------------|---------------------------------------|----------------|--|
| For Corners In: | | | |
| <u>Wexford</u> | Located In | Corner Code # | |
| (County) | | | |
| 1. Public Land Survey | T _____ R _____ | | |
| | T _____ R _____ | | |
| 2. Property Controlling in Section | S <u>29</u> T <u>24N</u> R <u>12W</u> | 16 | |
| | S <u>29</u> T <u>24N</u> R <u>12W</u> | <u>EW 1/64</u> | |
| 3. Miscellaneous Property in Section | S _____ T _____ R _____ | | |
| | S _____ T _____ R _____ | | |
| 4. Lot No: _____ | Recorded Plat: _____ | | |
| 5. Private Claims: _____ | | | |

Register of Deeds Stamp & File Number

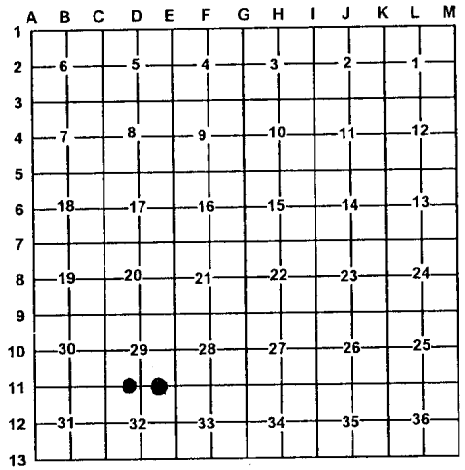

I, Craig W. McVean, in a field survey on June 9, 2008 do hereby state that under requirements of PA 74, Michigan PA of 1970, the corner points mentioned in lines 1 and 2 above were in conformance with regulations and rules therefore as required in the current manual of survey instructions of the United States Department of the Interior, Bureau of Land Management or by a decree of a Court of Law and/or that the corner points mentioned in lines 3, 4 and 5 above were in conformance with the rules of the Michigan Board of Land Surveyors or by a Decree of a Court of Law; established, re-established, monumented, recovered, found as expressed below:

NOTE: Not more than 2 corners, all in the same town and range, may be recorded on this certificate.

A. Description of original monument and accessories and/or subsequent restoration:

16 - 1913 - E. E. Sours - CSR - L. 2, p. 50 & 51 -
 Petition Survey Sec. 29 -
 Set corner, iron stake.
 No witnesses.
 Distance East & West 1342.5'

EW 1/64 - 1913 - E. E. Sours - CSR - L. 2, p. 50 & 51, set corner.
 No witnesses. Distance East to S 1/4 = 676.25'
 Distance West to SW Cor. of Section 29 = 2018.75'
 - 1979 - Unrecorded Survey - K. L. Ross - Ross
 Surveys - File No. R-133 - Set Conc. Mon.
 - 2003 - Rec. Survey - L. 532, p. 696 - J. T. Nordlund
 Fd. Ross Conc. Mon.

B. Description of corner evidence found and/or method applied in restoring or re-establishing corner:

16 - E 1/16 corner common to Sections 29 & 32 -
 Found 1 1/4" round iron bar per Sours. 1 1/4" iron accepted as
 best available evidence of the position of the corner.

EW 1/64 - Corner common to Sec. 29 & 32 being the SW Corner
 of the E 1/2 of the E 1/2 of the SW 1/4 of Sec. 29 - Found
 4" round concrete monument with 1/2" rebar, 0.3' above
 ground with fence remains E-W and North. No
 evidence of Sours position. Concrete monument
 accepted as best available evidence of the position of
 the corner.

C. Description of monument for corner and accessories established to perpetuate locating the position of the corner:

16 - 1 1/4" round iron bar.
 Set Blue Carsonite Post 1' North
 N13°E 4.50' to set nail & tag in W. side twin 18" Beech
 scribed 'XBT'
 S85°W 7.55' to set nail & tag in S. side 14" Beech
 scribed 'XBT'
 S01°W 12.44' to set nail & tag in W. side triple
 10", 15", & 19" Basswood
 S83°E 43.21' to set nail & tag in N. side 11" Sugar Maple

EW 1/64 - Epoxied a stamped 2" Aluminum cap onto 1/2" iron in
 concrete monument.
 Set Blue Carsonite Post with location tag 1' SE
 S74°W 56.30' to set nail & tag on N. side 14" Red Pine
 S09°W 13.39' to set nail & tag on NW side 13" Red Pine
 N88°E 51.43' to set nail & tag in N. side 6" Cherry
 North 73.18' to set nail & tag in W. side twin 14" Cherry
 with N-S fence remains.

Signed by: Craig W. McVean
 Surveyor's Michigan License No.: 39088

Date: 1/14/2009

