

LAND CORNER RECORDATION CERTIFICATE


Filing Requirement of Act 74, Mich. PA 1970

For Corners In: Wexford (County)	Located In	Corner Code #
1. Public Land Survey	T _____ R _____ T _____ R _____	_____
2. Property Controlling in Section	S 31 T 24N R 12W S 31 T 24N R 12W	2 3
3. Miscellaneous Property in Section	S _____ T _____ R _____ S _____ T _____ R _____	_____ _____
4. Lot No: _____	Recorded Plat: _____	
5. Private Claims: _____		

Register of Deeds Stamp & File Number

I, Craig W. McVean, in a field survey on June 4, 2008 do hereby state that under requirements of PA 74, Michigan PA of 1970, the corner points mentioned in lines 1 and 2 above were in conformance with regulations and rules therefore as required in the current manual of survey instructions of the United States Department of the Interior, Bureau of Land Management or by a decree of a Court of Law and/or that the corner points mentioned in lines 3, 4 and 5 above were in conformance with the rules of the Michigan Board of Land Surveyors or by a Decree of a Court of Law; established, re-established, monumented, recovered, found as expressed below:

NOTE: Not more than 2 corners, all in the same town and range, may be recorded on this certificate.

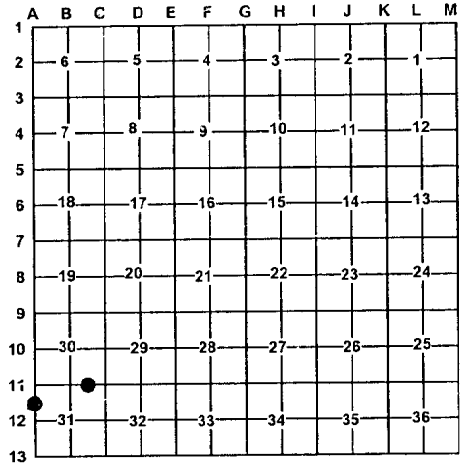

A. Description of original monument and accessories and/or subsequent restoration:

- 2 – **2003** – Recorded Survey L. 532, p. 700 - J. T. Nordlund.
Set monument. Distance E & W is 1337.05'
- 3 – **1913** – CSR – L. 2, p. 57 – E. E. Sours
1) Beech 14" S33°W 39.5
2) Elm 10" N51°W 32

B. Description of corner evidence found and/or method applied in restoring or re-establishing corner:

- 2 – E 1/16 Cor. common to Sections 30 & 31 - Set 2" stamped Aluminum cap on 5/8" x 34" rebar per Standard BLM procedure. Distance East 1332.52' to 'C11' and West 1332.52' to 'B11'.
- Reference Pt. – Fd. 4" round concrete monument with PS Cap #16345 is N44°29'W 6.30' from '2'. Appears there is a mistake in Nordlund's measurement in establishing this concrete monument. Concrete monument not utilized as corner '2' in this survey.
- 3 – N 1/16 Cor. common to Section 31, T24N R12W and Section 36, T24N, R13W – No evidence of Sours BT's or corner - Set 2" stamped Aluminum cap on 5/8" x 34" rebar per Standard BLM procedure. Flush with asphalt and 1.2' West of centerline N-S Rd. Field Line to East with 2-track on N. side of Field Line.

C. Description of monument for corner and accessories established to perpetuate locating the position of the corner:

- 2 – 2" stamped Aluminum cap on 5/8" x 34" rebar.
S14°W 30.40' to set nail & tag in W. side 20" Sugar Maple
S73°W 27.58' to set nail & tag in N. side Tri. 16", 8" & 8" Sugar Maple
N14°E 72.61' to set nail & tag in E. side 16" Red Pine
East 45.27' to set nail & tag in S. side 9" Cherry
N44°29'W 6.30' to found 4" round concrete monument with PS cap #16345 – Reference Pt.
Set Blue Carsonite Post with location tag 1' South
- 3 – 2" stamped Aluminum cap on 5/8" x 34" rebar
N58°E 64.78' to set nail & tag in SE side 20" Red Pine
N41°E 62.08' to set nail & tag in NW side 18" Red Pine
S44°W 60.13' to set nail & tag in NW side 22" Sugar Maple
East 33.00' to set 2" Aluminum cap on 5/8" x 34" rebar on line with Blue Carsonite Post with location tag.

Signed by:

Craig W. McVean

Date:

1/14/2009

Surveyor's Michigan License No.:

39088

