

LAND CORNER RECORDATION CERTIFICATE

Filing Requirement of Act 74, Mich. PA 1970

For Corners In:				
<u>Wexford</u>	Located In	Corner Code #		
(County)				
1. Public Land Survey	T _____ R _____			
	T _____ R _____			
2. Property Controlling in Section	S <u>32</u> T <u>24N</u> R <u>12W</u>	<u>9</u>		
	S <u>32</u> T <u>24N</u> R <u>12W</u>	<u>16</u>		
3. Miscellaneous Property in Section	S _____ T _____ R _____			
	S _____ T _____ R _____			


Register of Deeds Stamp & File Number

4. Lot No: _____ Recorded Plat: _____

5. Private Claims: _____

I, Craig W. McVean, in a field survey on May 28, 2008 do hereby state that under requirements of PA 74, Michigan PA of 1970, the corner points mentioned in lines 1 and 2 above were in conformance with regulations and rules therefore as required in the current manual of survey instructions of the United States Department of the Interior, Bureau of Land Management or by a decree of a Court of Law and/or that the corner points mentioned in lines 3, 4 and 5 above were in conformance with the rules of the Michigan Board of Land Surveyors or by a Decree of a Court of Law; established, re-established, monumented, recovered, found as expressed below:

NOTE: Not more than 2 corners, all in the same town and range, may be recorded on this certificate.

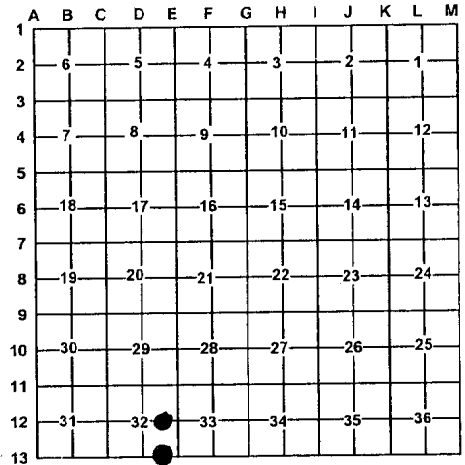

A. Description of original monument and accessories and/or subsequent restoration:

16 - None 9 - None

B. Description of corner evidence found and/or method applied in restoring or re-establishing corner:

16 - E 1/16 Corner common to Section 32, T24N, R12W and Section 5, T23N, R12W. Set stamped 2" Aluminum cap on 5/8" x 34" rebar per standard BLM procedure. Centerline of E-W Gravel road is 1.5' +/- South. Fence remains North. Fence remains South are 1' +/- East. S48°12'W 2.15' of corner '16' a 1/2" rebar with unreadable cap was found. This 1/2" rebar is based on a rejected position at 'D13-D1' and is not accepted in this survey.

9 - CE 1/16 Corner, Section 32 - Set 2" Stamped Aluminum cap on 5/8" x 34" rebar per Standard BLM procedure.

C. Description of monument for corner and accessories established to perpetuate locating the position of the corner:

16 - Stamped 2" Aluminum cap on 5/8" x 34" rebar, drove down 0.5' below grade.
 North 33.01' to set 2" Aluminum cap on 5/8" x 34" rebar on line with Blue Carsonite post with location tag
 S01°W 37.64' to set nail & tag in W. side P.P.
 N65°W 87.76' to set nail & tag in NE side twin 22" Sugar Maple
 S44°E 67.00' to set nail & tag in SW side 6" Red Pine
 S48°12'W 2.15' to found 1/2" rebar

9 - Stamped 2" Aluminum cap on 5/8" x 34" rebar
 S24°W 14.37' to set nail & tag in W. side 27" Cherry
 N12°E 25.71' to set nail & tag in W. side 5" Red Maple
 N35°W 46.10' to set nail & tag in NE side 18" Cherry
 N67°W 119.06' to set nail & tag in S. side 8" Ash
 Set Blue Carsonite post with location tag 1' NW

Signed by: Craig W. McVean
 Surveyor's Michigan License No.: 39088

Date: 1/14/2009

