



T 15, R 3E

Witnesses to $\frac{1}{4}$ Corner, between
SECTIONS 22 & 27.


$\frac{1}{4}$ " Pipe, with 3 Bricks
fan shape around here.

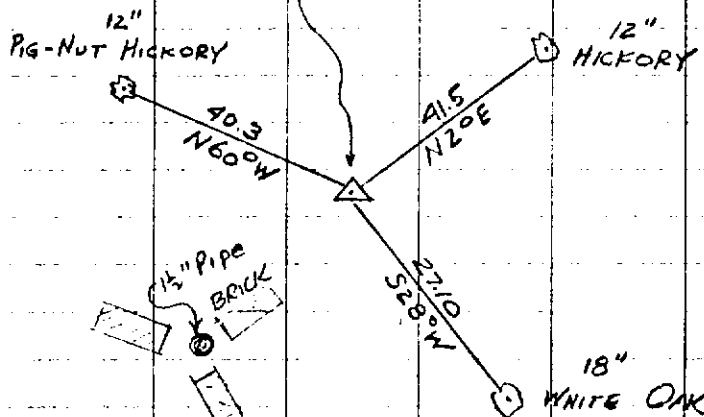

This corner is $\frac{1}{4}$ mile East of M-92
at intersection of an old fence going N & S
and the dirt road E & W.

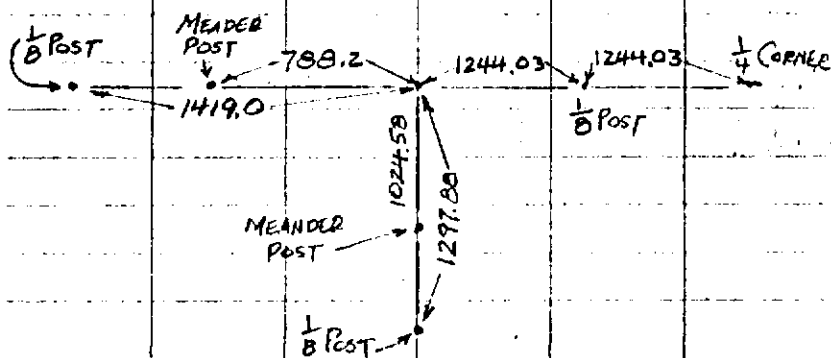

GREEN LAKE, WATERLOO RECREATION
T 15, 3E, R 3E (43)
OUR EAST $\frac{1}{8}$ CORNER to $\frac{1}{4}$ ROAD = 94.0'

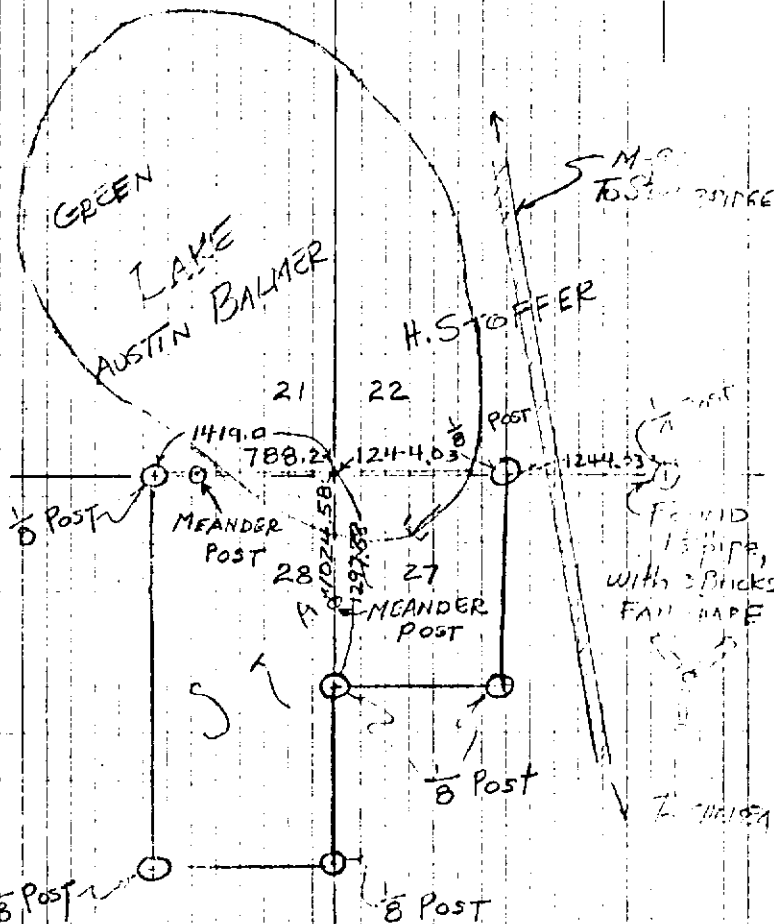

WASHTENAW