

Form 280
(Rev. 3/60)

GOV'T. MONUMENT WITNESSES RECORD

T.-1-S R.-3-E

SECTION

2655.76'

16

WITNESSES

14" Oak	N-5-E	27.76'
13" Oak	N-21-E	14.80'
14" Oak	N-81-E	22.22'
14" Oak	S-20-E	20.64'
18" Oak	S-2-E	35.13'


Fences N-S & East.

SEC. NO. # 16

DESCRIPTION
SECTION CORNER COMMON TO SECTIONS
8-9-16 & 17 LYNDON TWP. WASH. COUNTY.

1" IRON PIPE FENCES N+S & EAST.

MSHD REF. TAGS IN ALL TREES

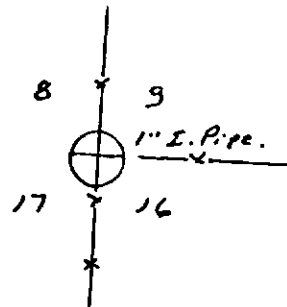

MICHIGAN STATE HIGHWAY DEPARTMENT

MAX W. WALTER
SURVEY CHIEF

MARCH 6, 1961
DATE 2-5

Form 280
(Rev. 3/60)

GOV'T. MONUMENT WITNESSES RECORD

T.-1-S R.-3-E

SECTION

2653.96'

2667.13'

16

WITNESSES


18" HICKORY	DUE S	116.75'
RR Tie Fe. Post	W	7.27'
T. P.	DUE N	43.37'

SEC. NO. 16

DESCRIPTION
3/4" IRON PIPE ON S SIDE CORNER FE. POST
W/FENCES NORTH+SOUTH & WEST.

1/4 CORNER COMMON TO SECTIONS 16 & 17
T-1-S R-3-E Lyndon TWP., WASH. COUNTY.

MSHD REF. TAGS IN ALL WITNESSES

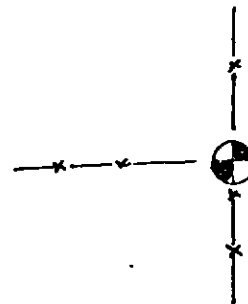

MICHIGAN STATE HIGHWAY DEPARTMENT

MAX W. WALTER
SURVEY CHIEF

MARCH 6, 1961
DATE 2-6